




ELEVATION

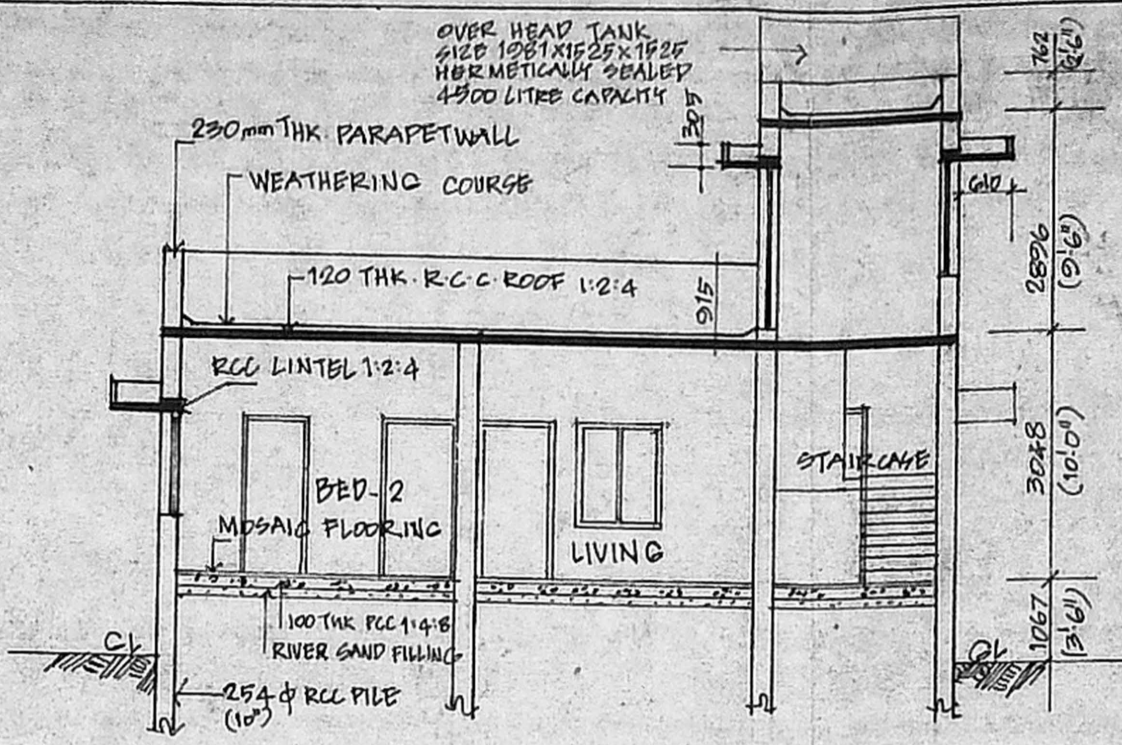


SECTION ON AA

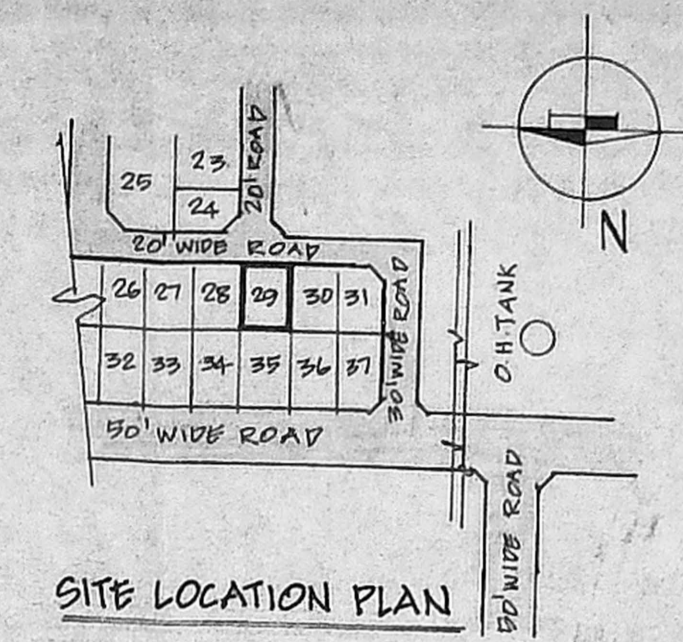


SITE LOCATION PLAN

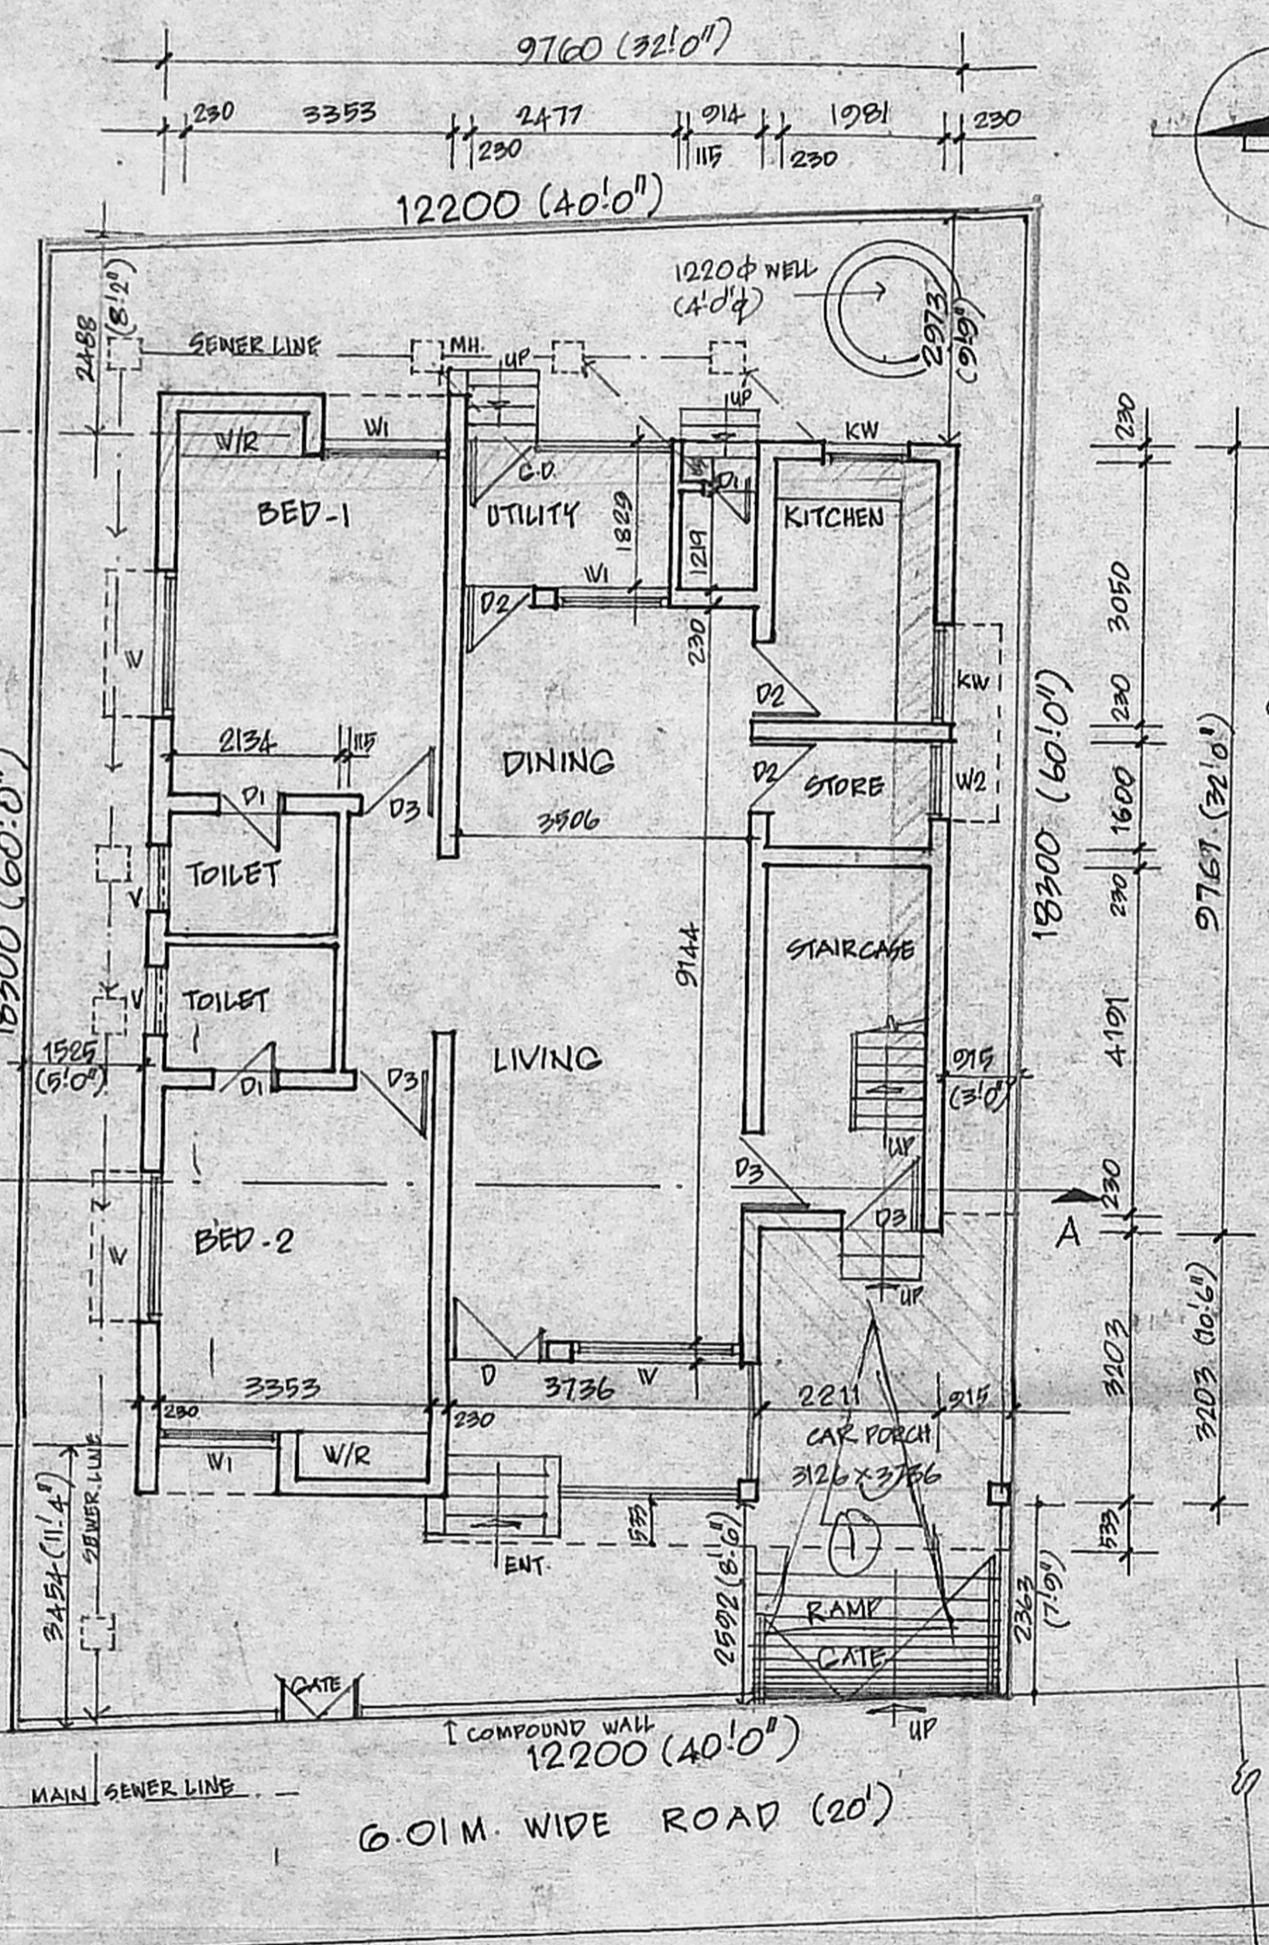


GROUND FLOOR PLAN IN SITE PLAN

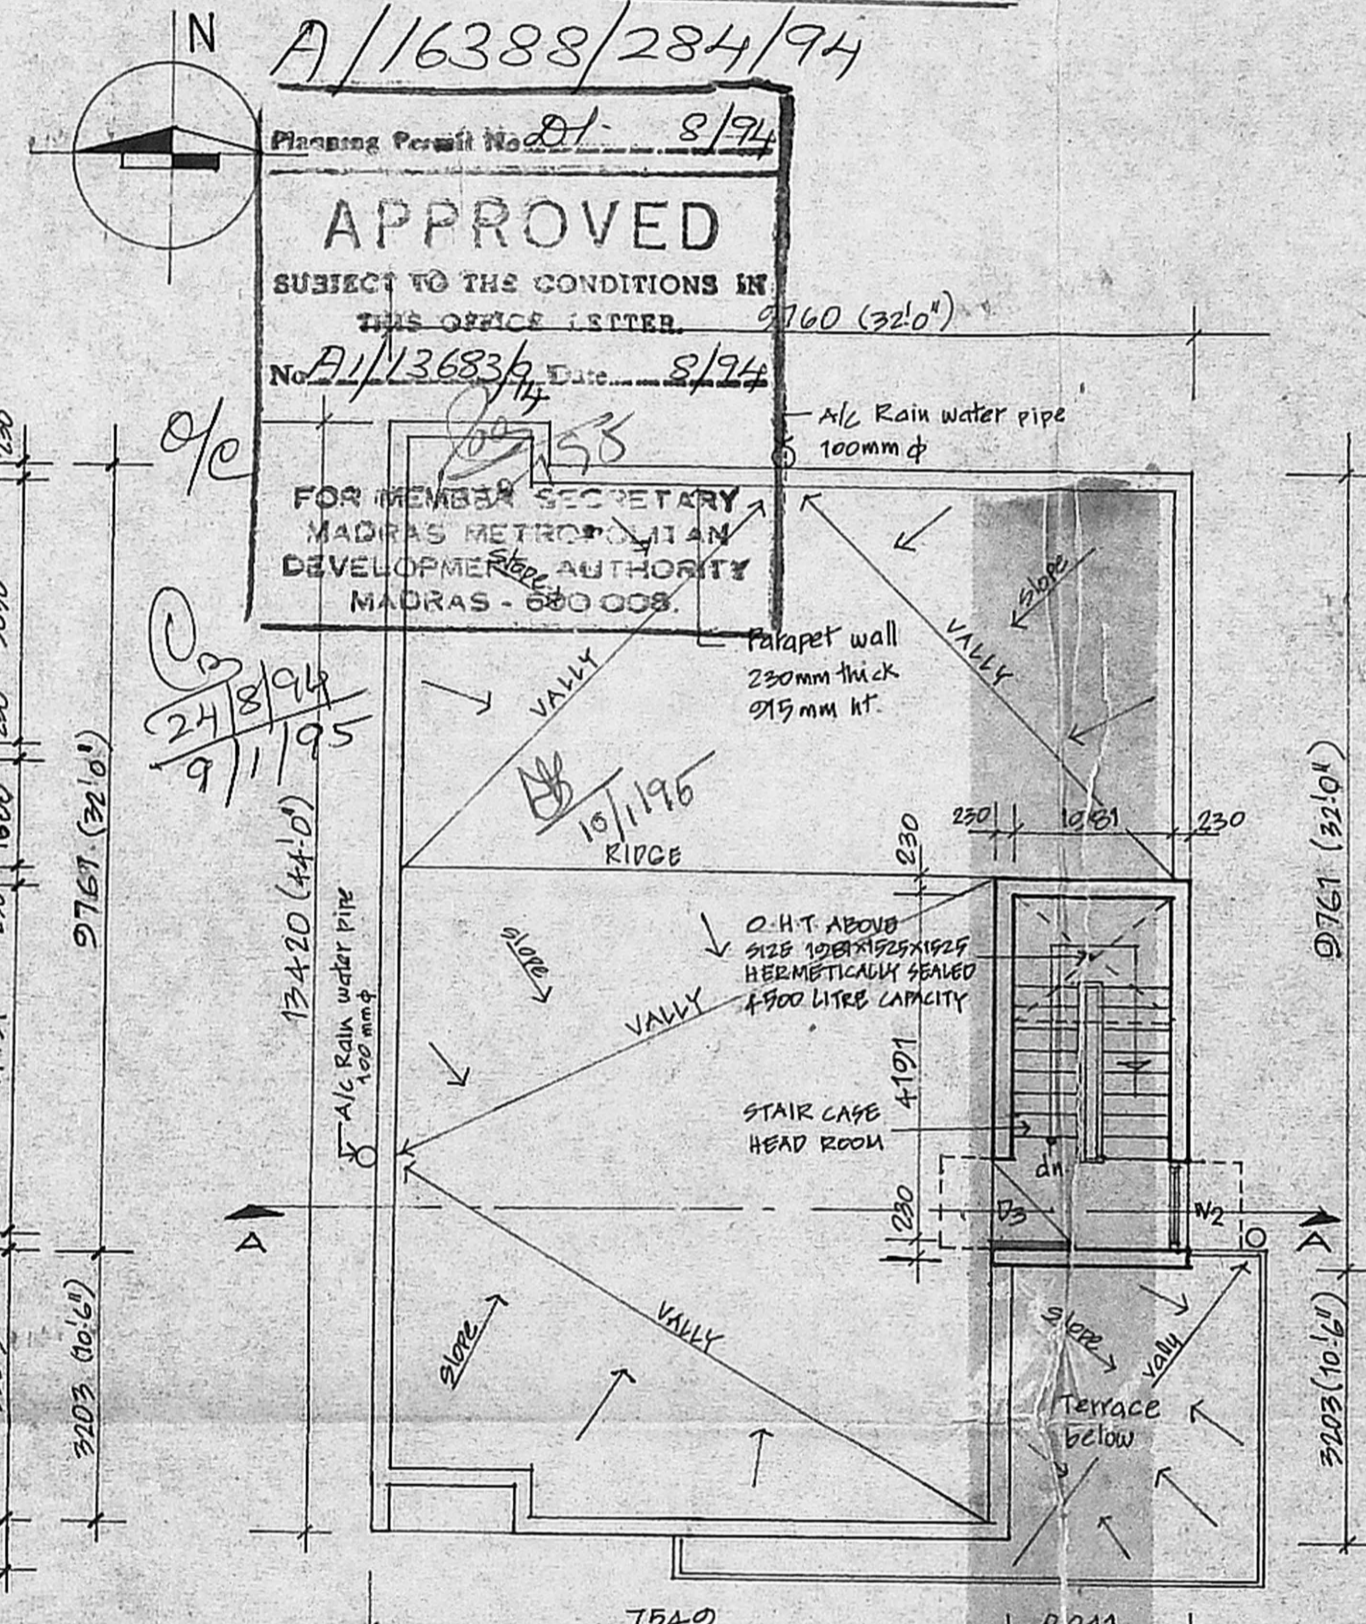


TERRACE FLOOR PLAN

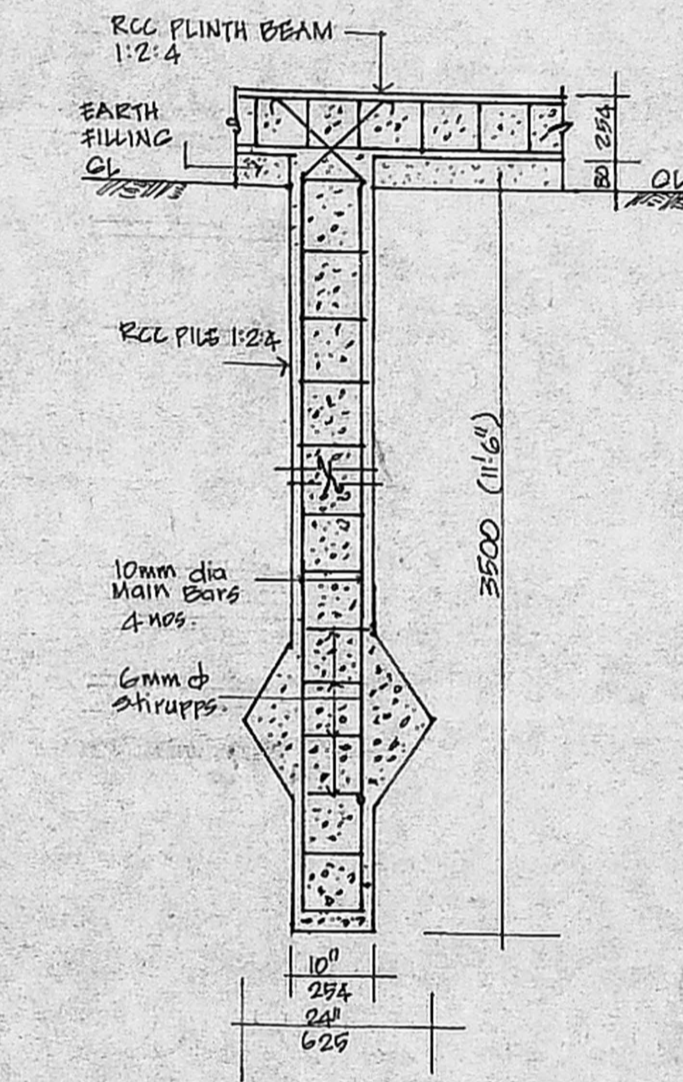

PILE FOUNDATION

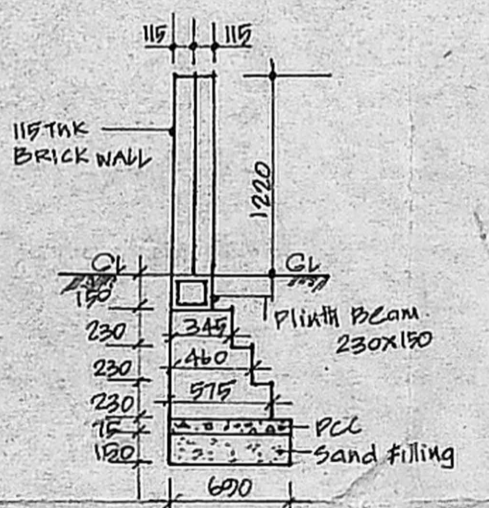

COMPOUND WALL DETAIL

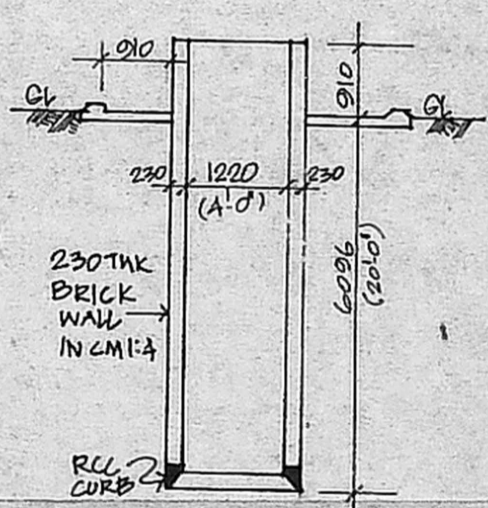

WELL DETAIL

APPROVED
 SUBJECT TO THE CONDITIONS IN THIS OFFICE LETTER
 No. A/13683/94 Date: 8/94
 FOR MEMBER SECRETARY
 MADRAS METROPOLITAN
 DEVELOPMENT AUTHORITY
 MADRAS - 600 008.

Sealing plan
 A/13683/94

LICENSED SURVEYOR CLASS I R.A. NO. 303
 APPLICANT
 ALBAN JOSEPH REBELLO
 B.Arch. M.T.P. F.I.A. A.I.T.P.
 REGISTERED ARCHITECT CA/77/L/14.2
 59 ORMES ROAD KILPAUK MADRAS-10
 S-A. JABBAR

SPECIFICATION
 ALL BRICK WORK IN CM 1:4 MIX
 ALL PCC WORK MIX IN 1:4:8
 ALL RCC WORK MIX IN 1:2:4
 ALL SAND FILLING TO BE OF PURE RIVER SAND
 ALL WOOD WORK TO BE FIRST CLASS TEAKWOOD
 ALL PLASTERING IN CM 1:4 MIX

SCHEDULE OF JOINERY

TYPE	DESCRIPTION	WIDTH	HEIGHT
D	TW PANALLED DOOR	1219	2134
D1	do	762	2134
D2	do	914	2134
D3	do	1067	2134
W	TW GLAZED WINDOW	2134	1372
W1	do	1372	1372
W2	do	1067	1372
KW	KITCHEN WINDOW	1067	1016
V	TW GLAZED VENTILATOR	914	610

AREA STATEMENT

DESCRIPTION	AREA
PLOT AREA	= 223.00M ² (2400 CFT)
Ground floor area (including car porch)	= 135.41M ²
Stair case head room area	= 11.35M ²
Total built up area	= 146.76M ²
Plot coverage	= 60.7%
F.S.I	= 0.60

LEGEND
 PROPOSAL
 Regularisation ROAD
 BOUNDARY
 SEWER LINE
 EXISTING

Existing house for
 Mr. S.A. JABBAR
 at PLOT NO A.29 ARUMBAKKAM
 S & S SCHEME

NOTE
 ALL DIMENSIONS ARE IN MM

AS BUILT PLAN FOR APPROVAL

TITLE
 FLOOR PLAN ELEVATION SECTION etc.

PROJECT NO:

SCALE 1:100	REVISION	SHEET NO.
DATE 29.6.94		
DRAWN V.G. Sekar		
CHD		