
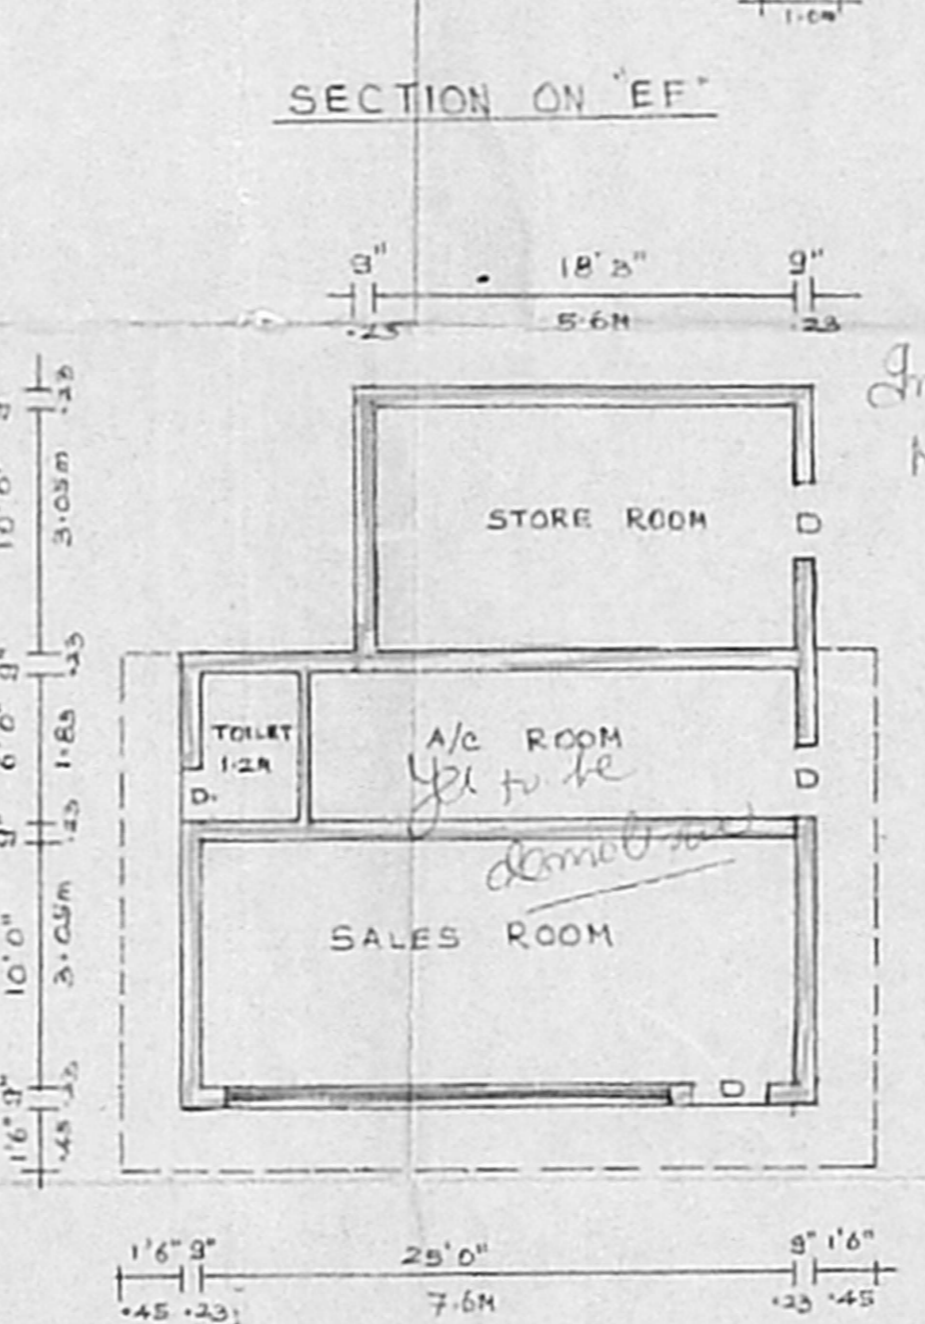
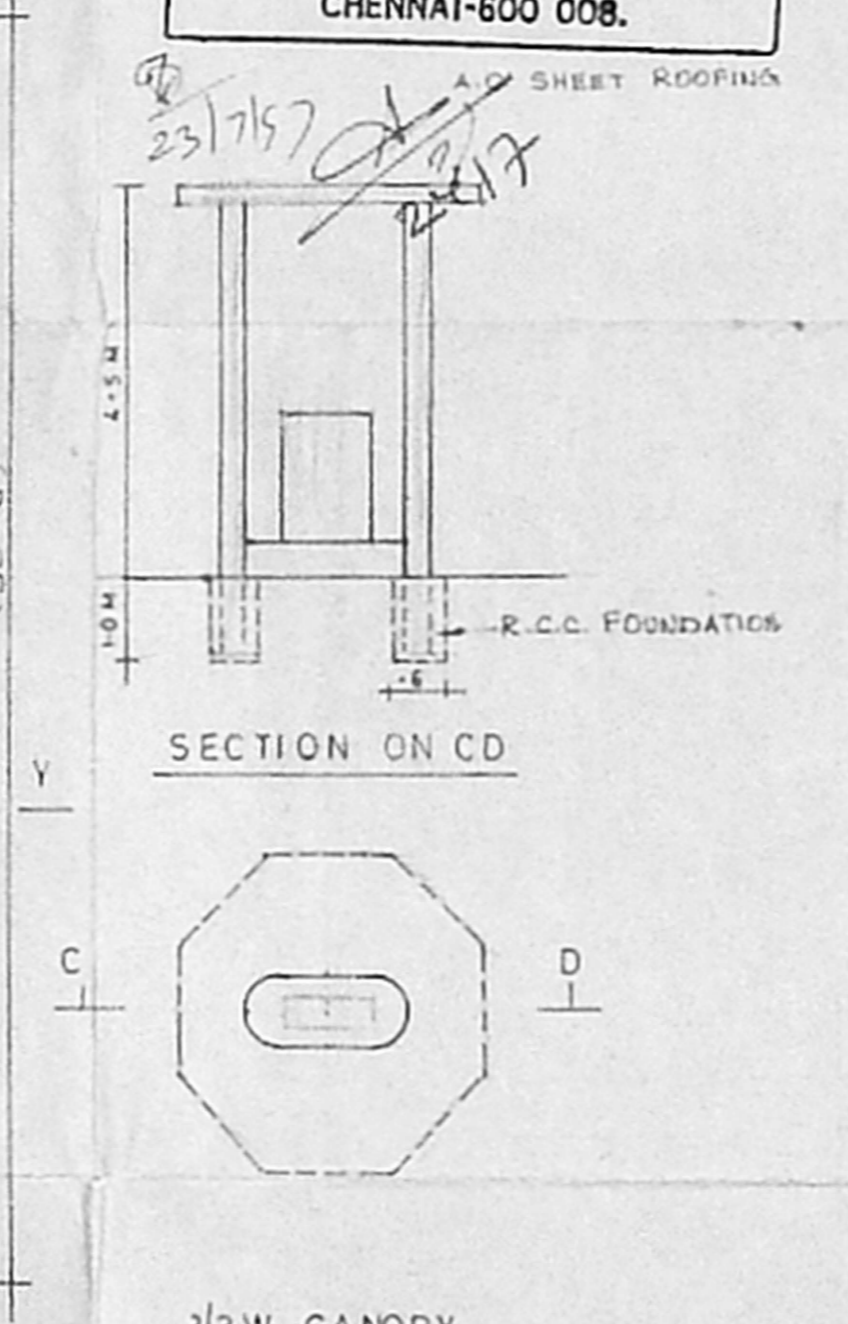
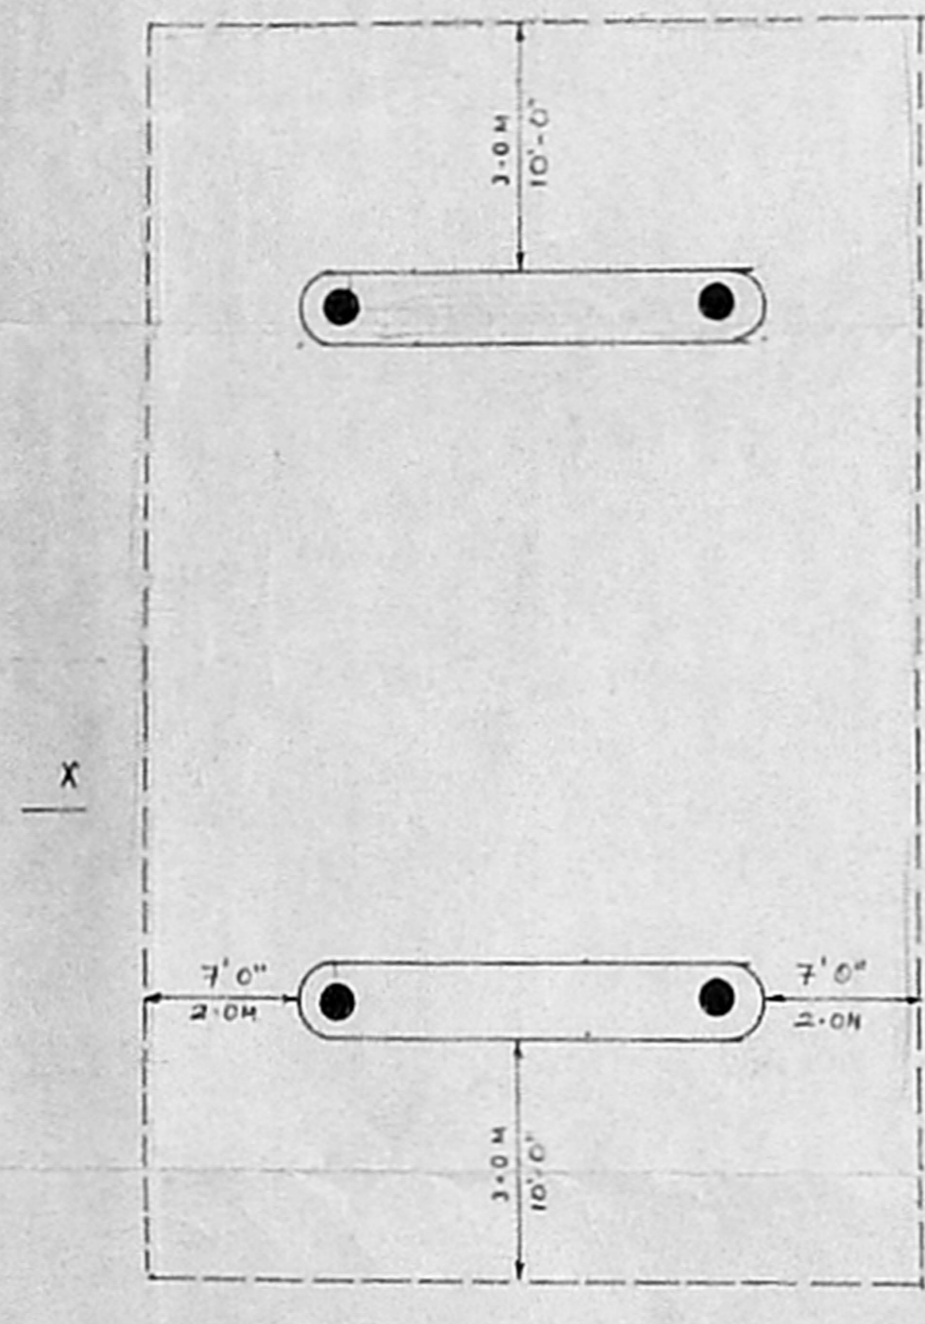
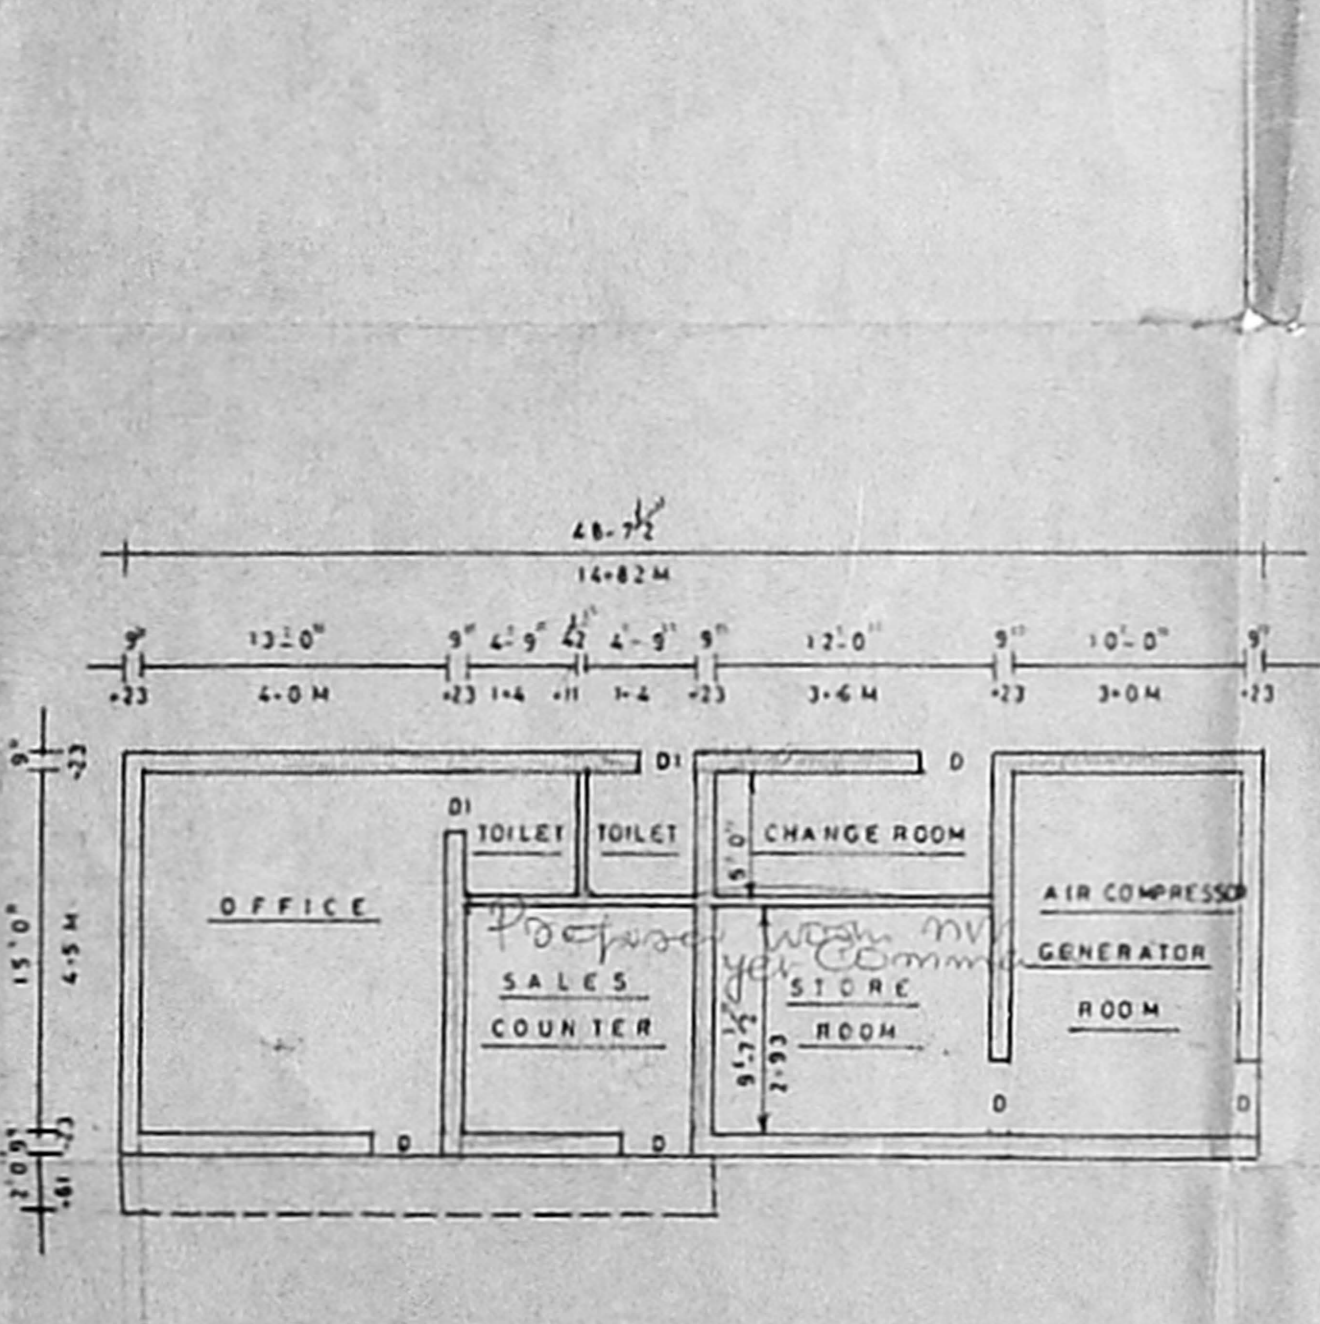
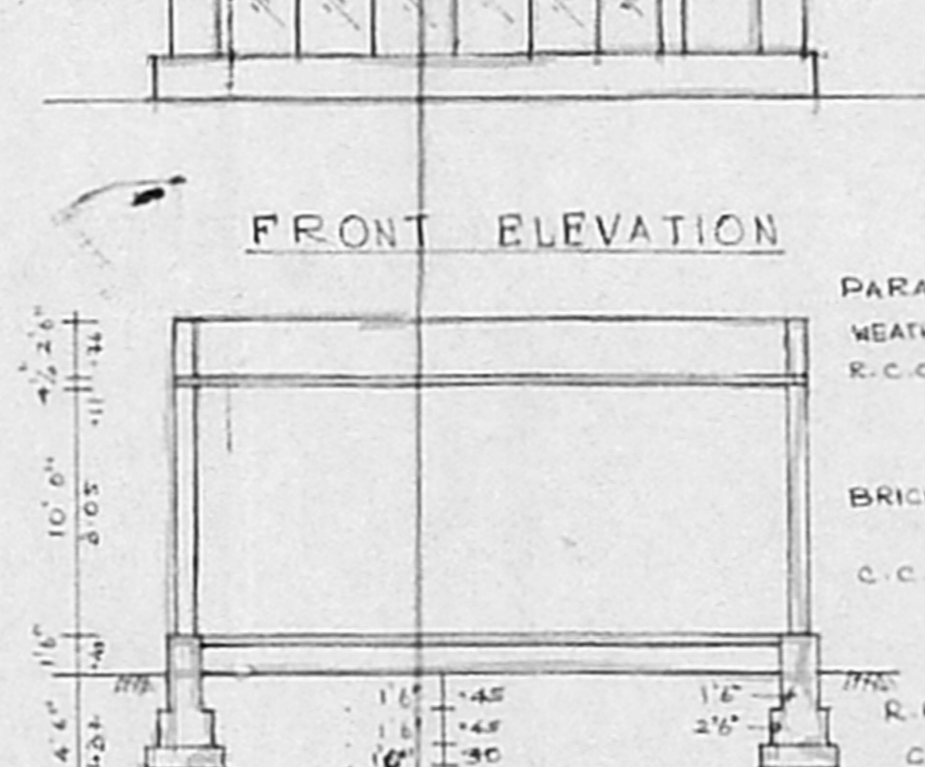
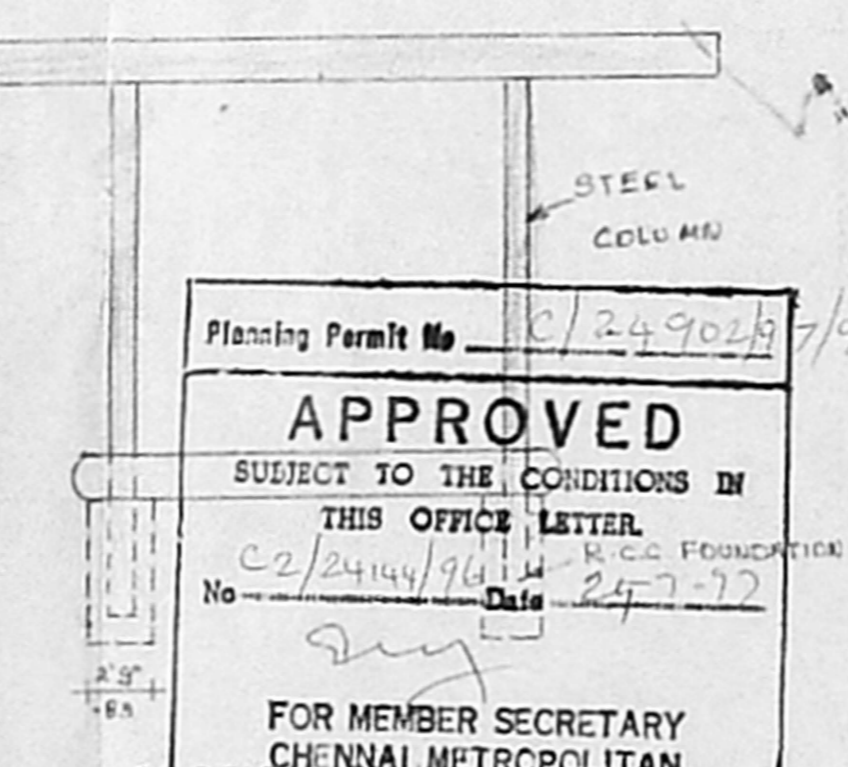
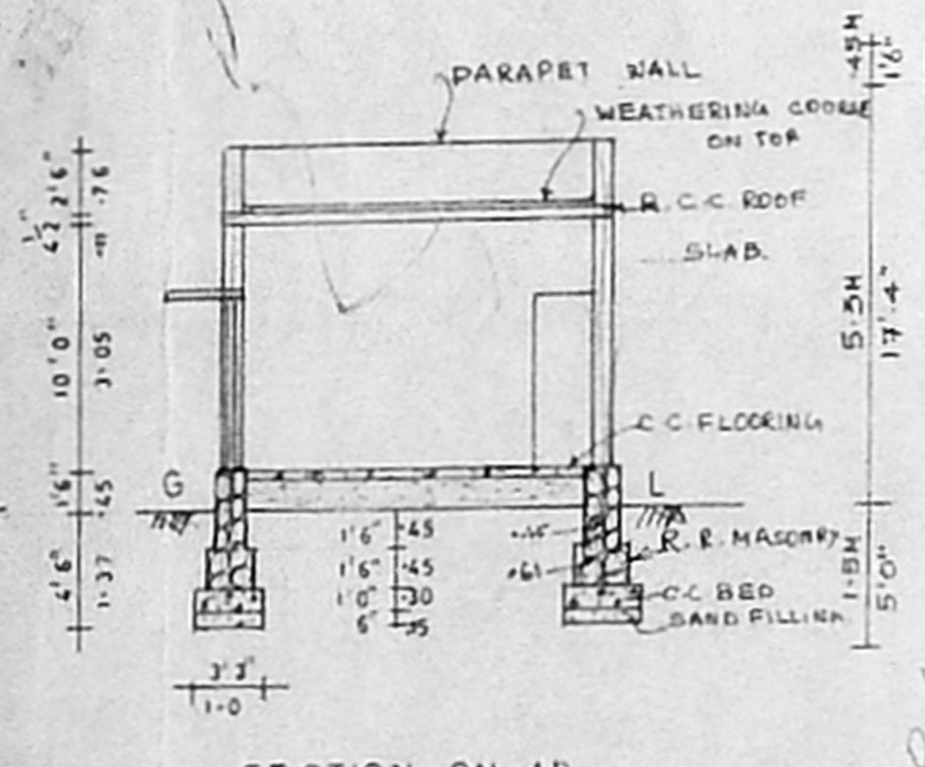



PLAN SHOWING THE PROPOSED CONSTRUCTION OF A SALES BUILDING WITH INSTALLATION OF 5 H.P. PETROL PUMP FOR INDIAN OIL CORPORATION LTD UNDER S. No. 29/A2 G.S.T. ROAD AT PALLAVARAM VILLAGE, CHINGLEPUT M.G.R. DISTRICT (M/s. VETRIKUMARAN)

SCALE 1:100


NOTE: PROPERTY TAX BOOK No. 667
RECEIPT No. 7992

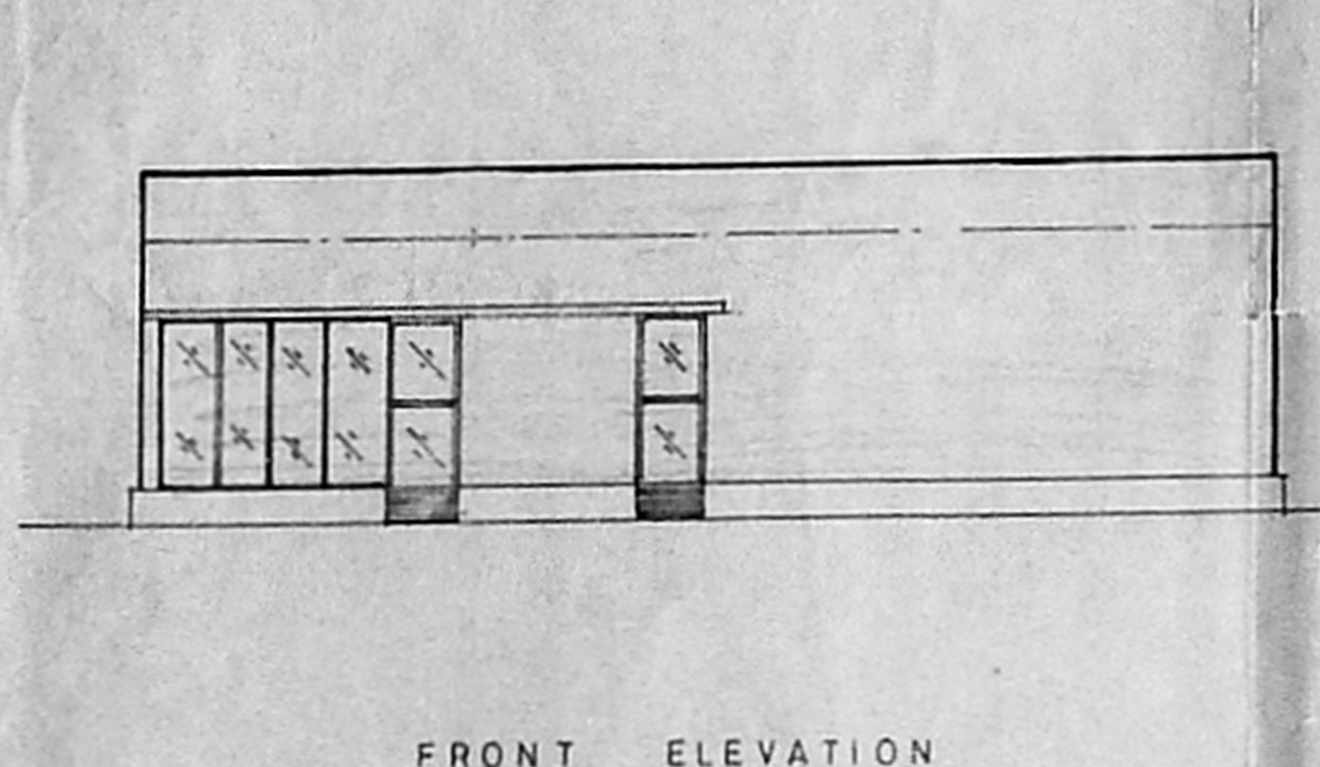

Planning Permit No. C/249028/97
APPROVED
SUBJECT TO THE CONDITIONS IN THIS OFFICE LETTER
No. C2/249028/96 Date 24-7-97
FOR MEMBER SECRETARY
CHENNAI METROPOLITAN
DEVELOPMENT AUTHORITY
CHENNAI-600 008.

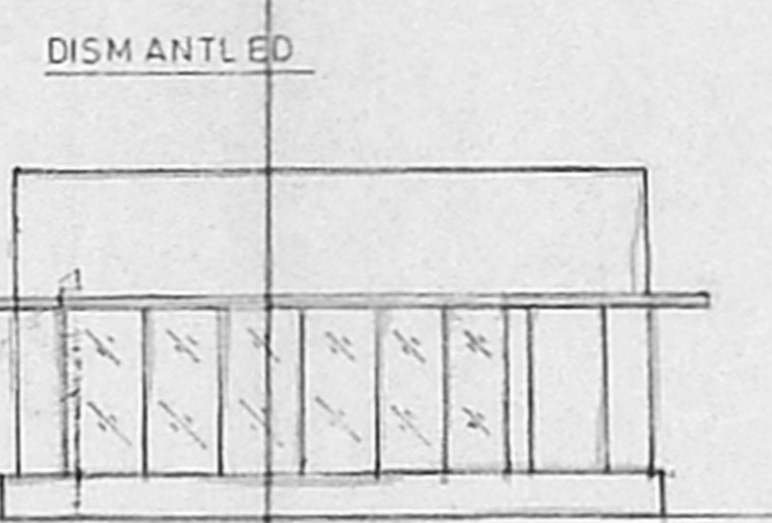


FRONT ELEVATION

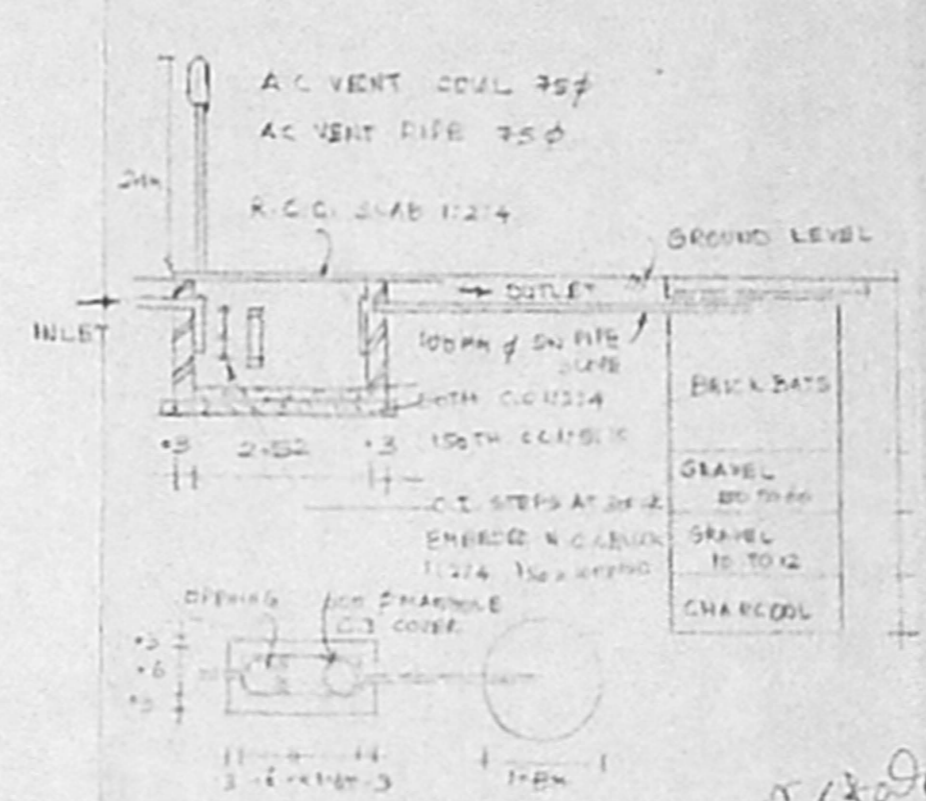

KEY PLAN
NOT TO SCALE

MMDA 'C' / PP No. 1
C.N. C2/249028/96
LAKSHMI THEATRE
35.86
EXISTING R.O. MODERN POSITION 35.86
PRO SITE
THEATRE ROAD
HADRAS
G.S.T. ROAD
TAMBARAM

Part I
Part II
20/12/96
AP

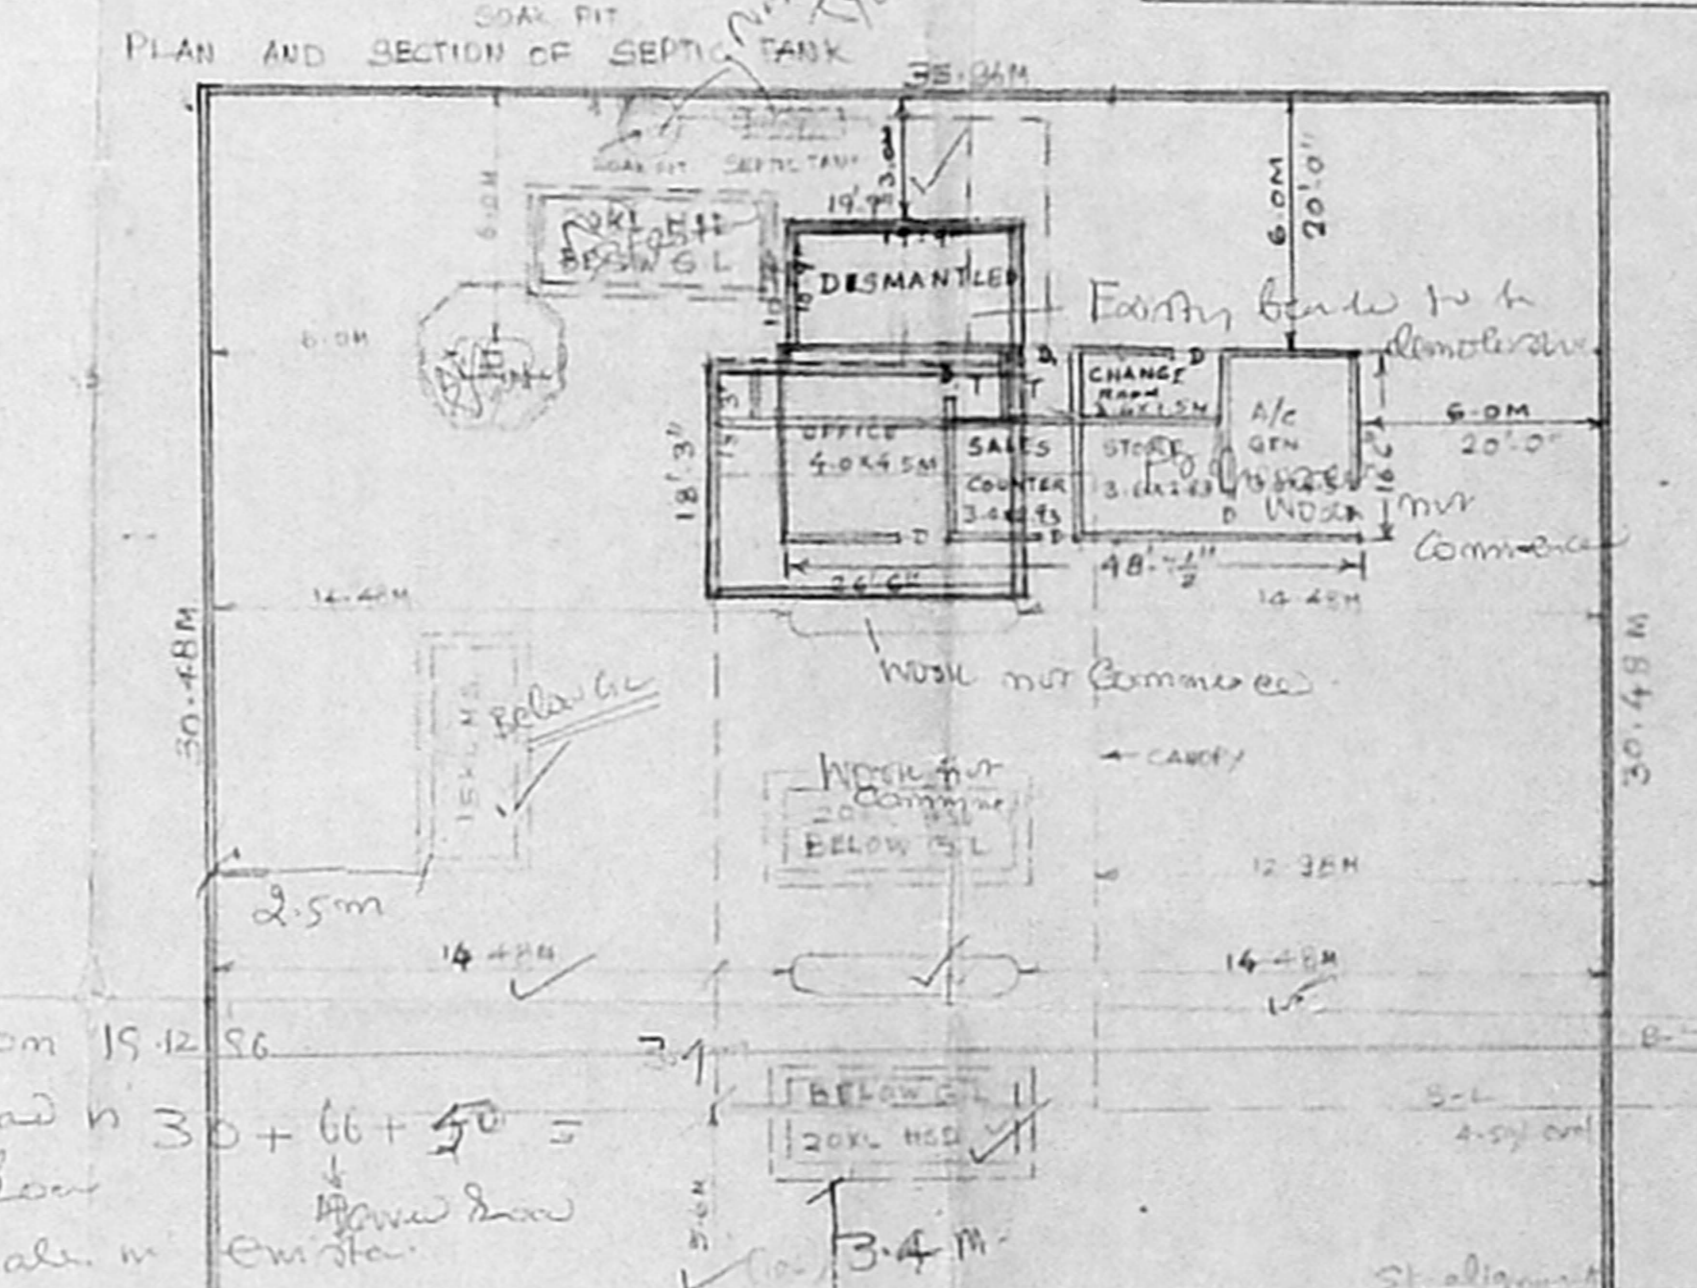

REFERENCE

D - DOOR	3'0" x 7'0" x .31 x 2.1m
D - DOOR	2'6" x 6'0" x .76 x 1.8m
GW - GLASS WINDOW	6'6" x 7'0" x 2.0 x 2.1m
J - JALEEY	5'0" x 5'0" x 1.5M x 1.5M
V - VENTILATOR	2'0" x 2'0" x .61 x .61

COLOURING DETAILS
BOUNDRY SHOWN IN BLACK
PROPOSAL SHOWN IN RED
DISMANTLED SHOWN IN YELLOW
ROADS ARE IN GREEN

AREA DETAILS

TOTAL AREA OF THE SITE	94 Ft	5A m.
PLINTH AREA OF EXG. G.F. (DISMANTLED)	695.9	64.6
PLINTH AREA PRO. G.F.	802.31	74.56

INDIAN OIL CORPORATION LTD.
(MARKETING DIVISION)
NO. 739, ANNA SALAI,
MADRAS-600 002.

LICENSED SURVEYOR
S. ASHOK KUMAR
Consultant & Contractor
LICENSED SURVEYOR
TAMIL NADU MUNICIPALITY
ALANKOTTA MUNICIPALITY
OLDERS
Office: 10, Dhargu Rd., Rajaji Nagar,
Pallavaram, Madras-600 043
Phone: [blank]

Inspector the site on 15.12.96
Name of the road is 30 + 66 + 50 =
Public lanes low
Street light also in existence.
Drainage not provided
Existing boundary to be demarcated
Proposed work not to be commenced
19/12/96

50'-0" Foot path (Mtd)

