

PLAN SHOWING THE PROPOSED

RESEARCH LAB & TRAINING CENTER 13/
T. DOOR NO. 141, AGANATHAN ROAD,
INGAMBakkAM, CHENNAI-600 034
2. தி.ஆ.

BLOCK NO:20,NUNGAMBAKKAM,EGMORE,
NUNGAMBAKKAM ~~CHENNAI~~ TAMIL NADU.
WARD NO: CORPN. ZONE- VII

SCHEDULE OF JOINERY

ID	TYPE	DESCRIPTION	SIZE
01	MD	MAIN DOOR	[1.83x2.13] 6'0" x 7'0"
02	D	DOOR	[1.83x2.13] 6'0" x 7'0"
03	D4	DOOR	[1.20x2.13] 4'0" x 7'0"
04	D2	DOOR	[1.96x2.13] 6'4" x 7'0"
05	D3	DOOR	[0.81x2.13] 2'7" x 7'0"
06	D4	DOOR	[0.81x2.13] 2'7" x 7'0"
07	W	WINDOW	[1.85x1.57] 6'0" x 4'6"
08	W1	WINDOW	[1.22x1.57] 4'0" x 4'6"
09	W2	WINDOW	[0.80x1.57] 2'7" x 4'6"
10	V1	VENTILATOR	[1.22x0.40] 3'0" x 1'0"

SPECIFICATIONS

- PCC 1:5:10 FOR FOUNDATION AND PUC 1:4:8 FOR BASEMENT
 - R.D.C M25 FOR COLUMN BEAM ROOF SLAB LINTEL AND SUBSTRUCTURE. THE MINIMUM SIZE OF THE COLUMN IS 300 MM.
 - BRICK WORK FOR UPPER STRUCTURE IN CEMENT MORTAR IN 1:6.
 - PLASTERING IN CEMENT MORTAR IN 1:5 FOR CEILING AND CEMENT MORTAR 1:5 FOR WALL PLASTERING
 - TEAK WOOD FOR DOORS & WINDOWS
 - BRICK JELLY LIME CONCRETE FOR WEATHERING COURSE WITH ONE COURSE OF PRESS TILES OVER THE WEATHERING COURSE
 - MOSAIC FLOORING

NOTE: ARCHITECTURAL FIN WHERE PROVIDED:
60 CM FROM ALL AROUND THE MAIN WALL

COLOUR CODE REFERENCE

PROPOSED
EXISTING ROAD
BOUNDARY LINE
WATER LINE
SEWER LINE

For Lister Metropolis Laboratory and Research Centre Pvt. Ltd.,
Avinash Varanasi
A rich blend of experience


~~SIGNATURE OF OWNER~~

1071. SURVEYOR'S HANDBOOK NO. 258 C-5
FEDERAL BUREAU OF INVESTIGATION
U.S. DEPARTMENT OF JUSTICE
LICEN


NATURE OF ARCHITECT

2


PROFESSIONAL SURVEYOR

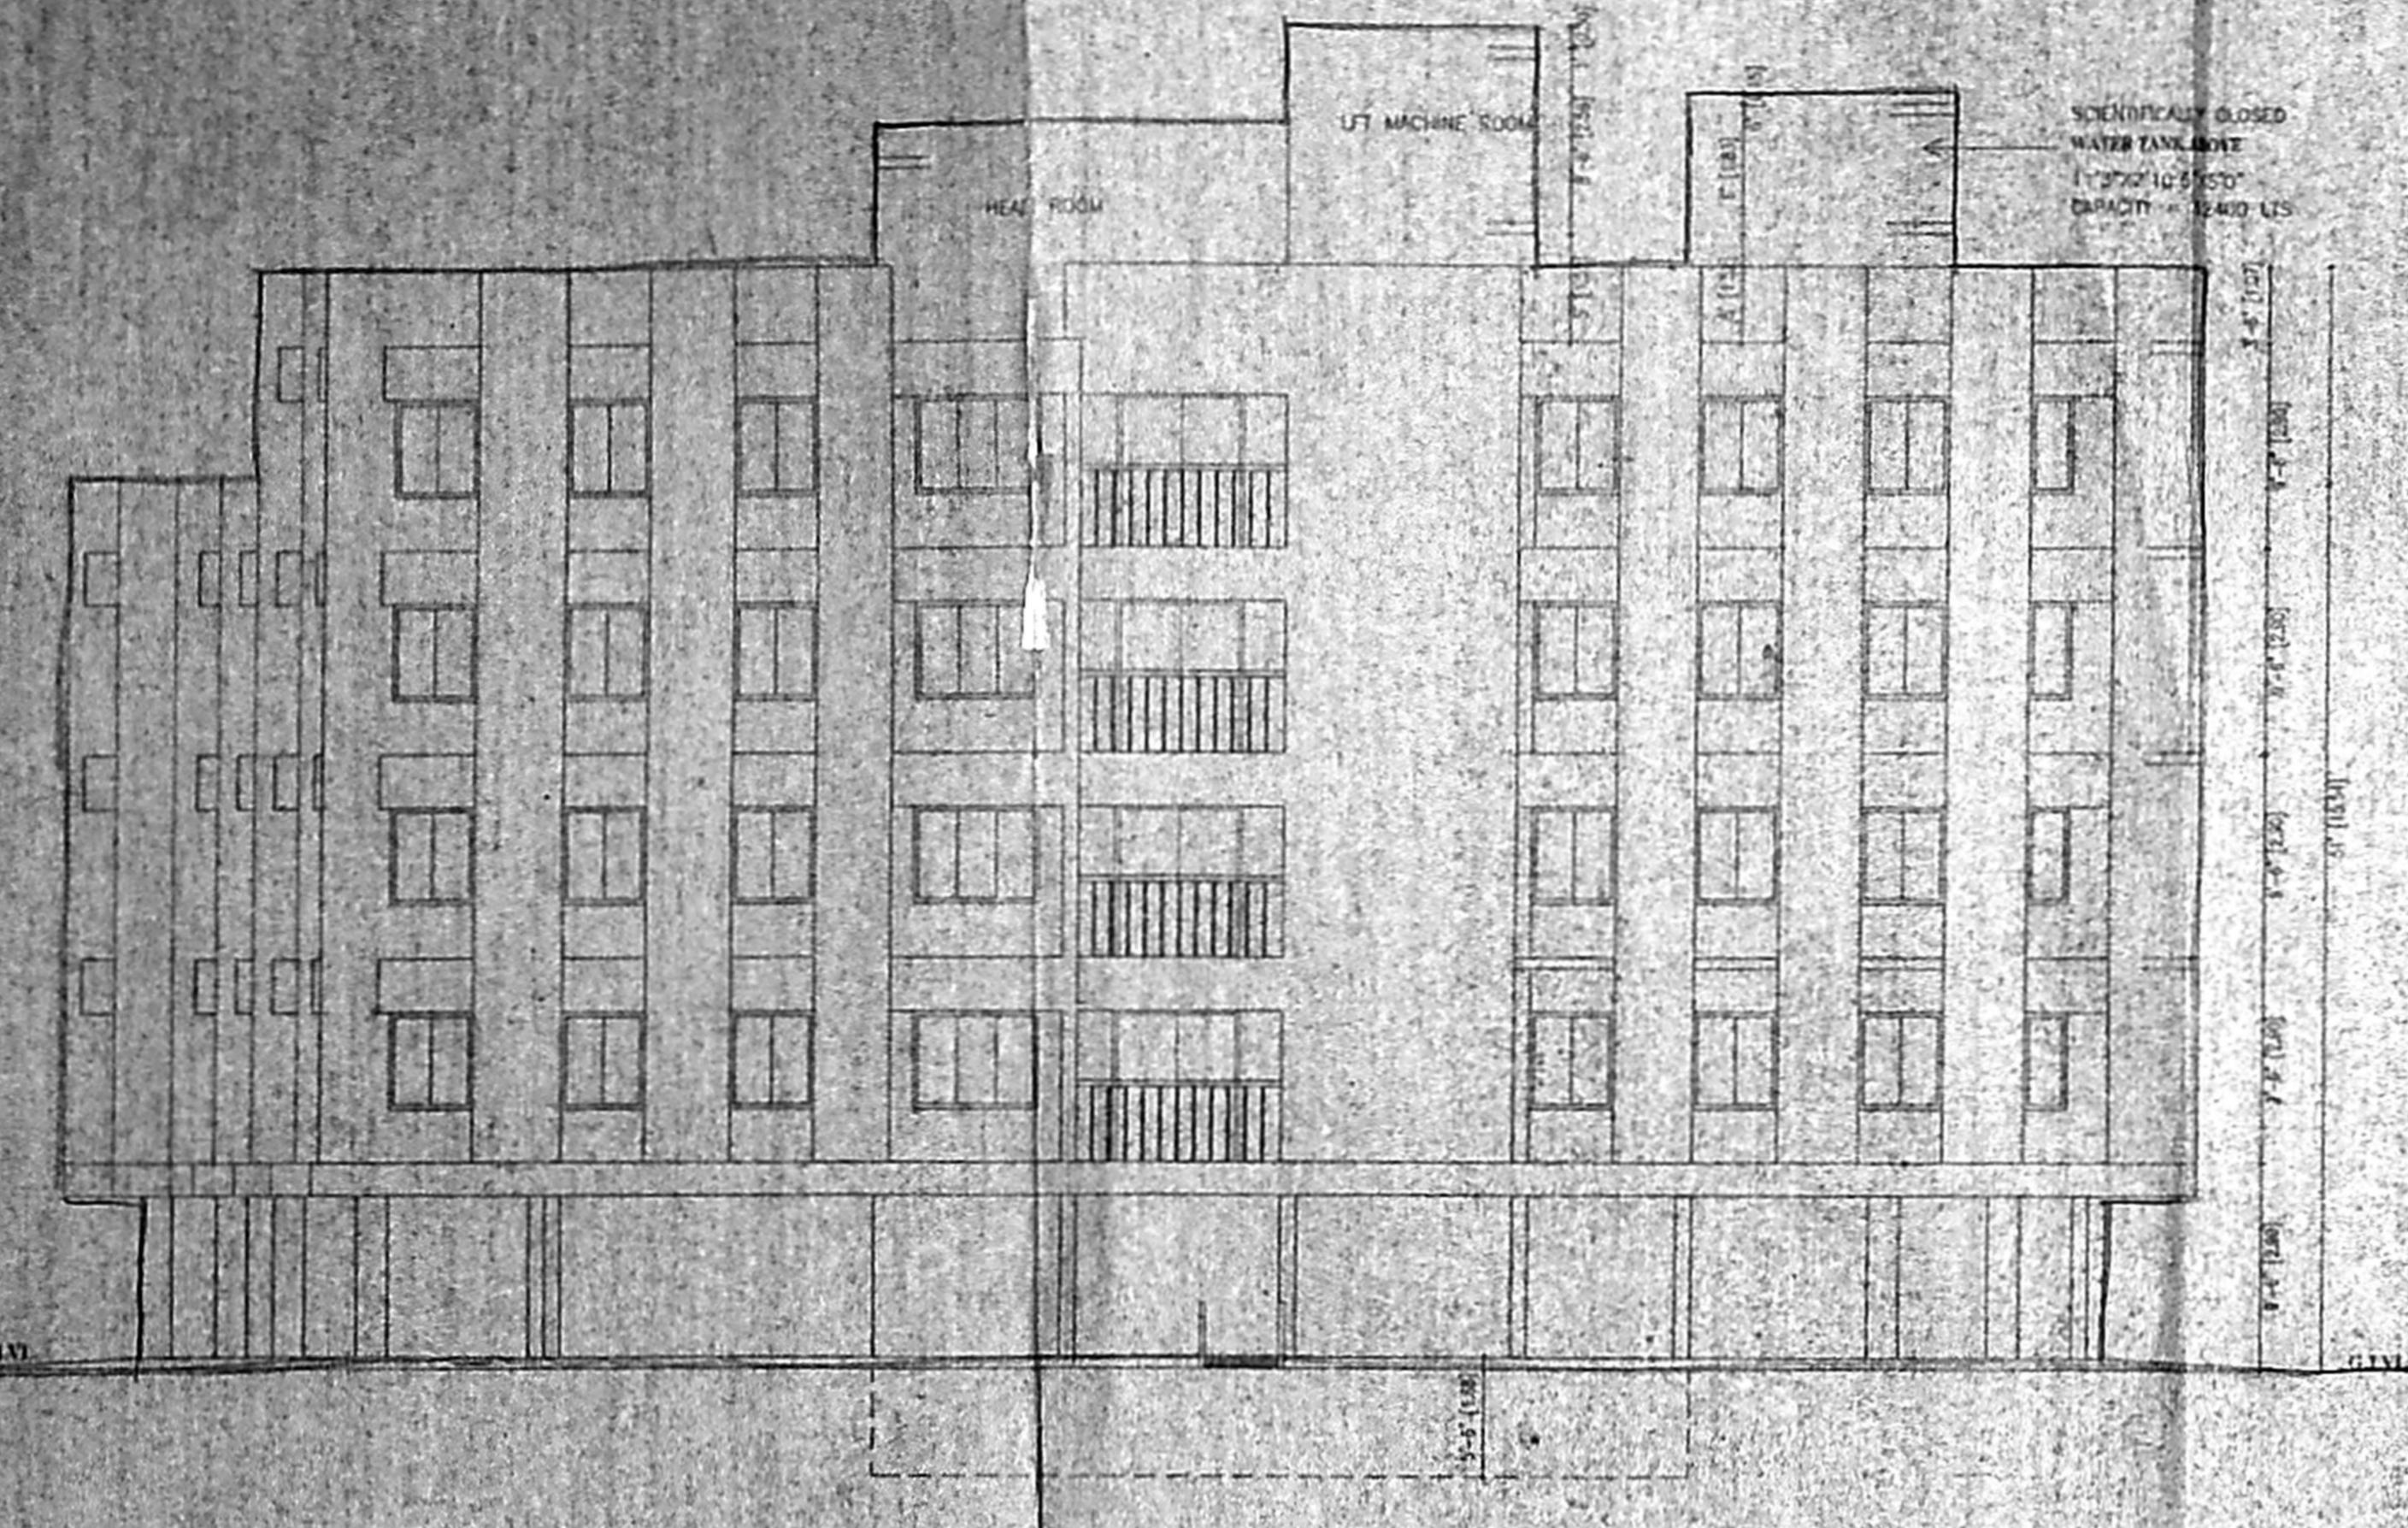


FRONT ELEVATION

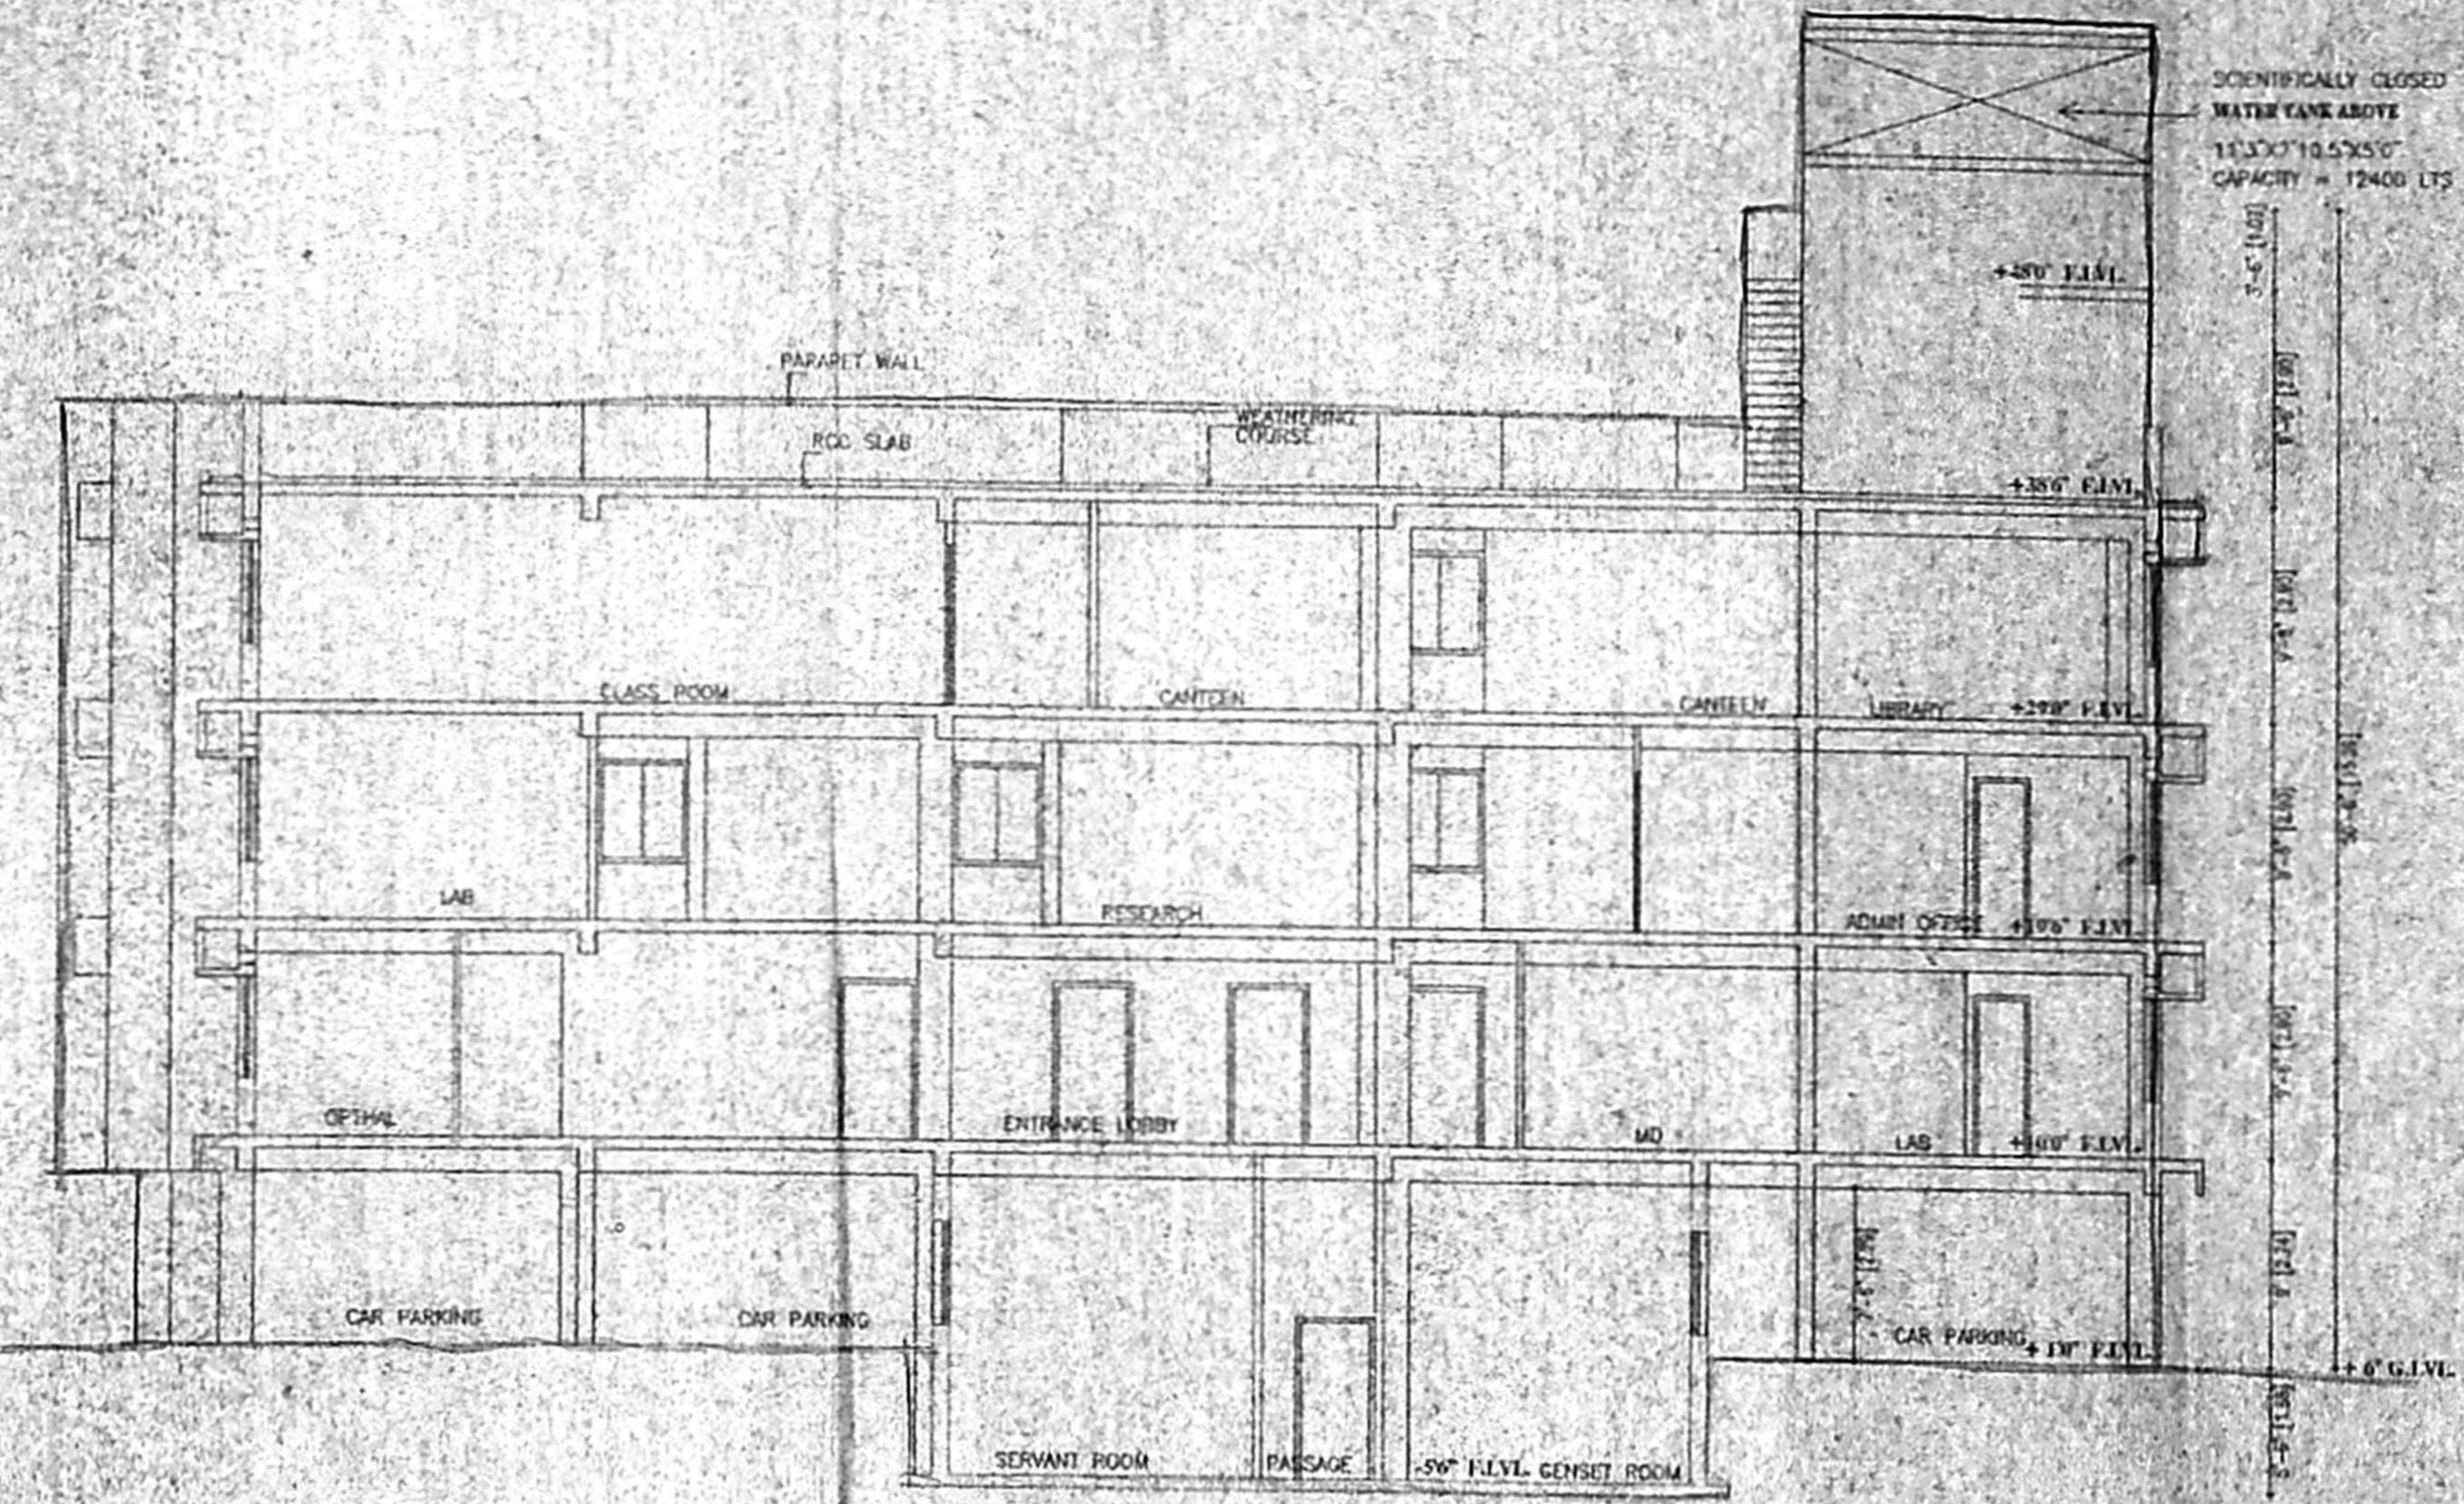

SECTION AT A-A

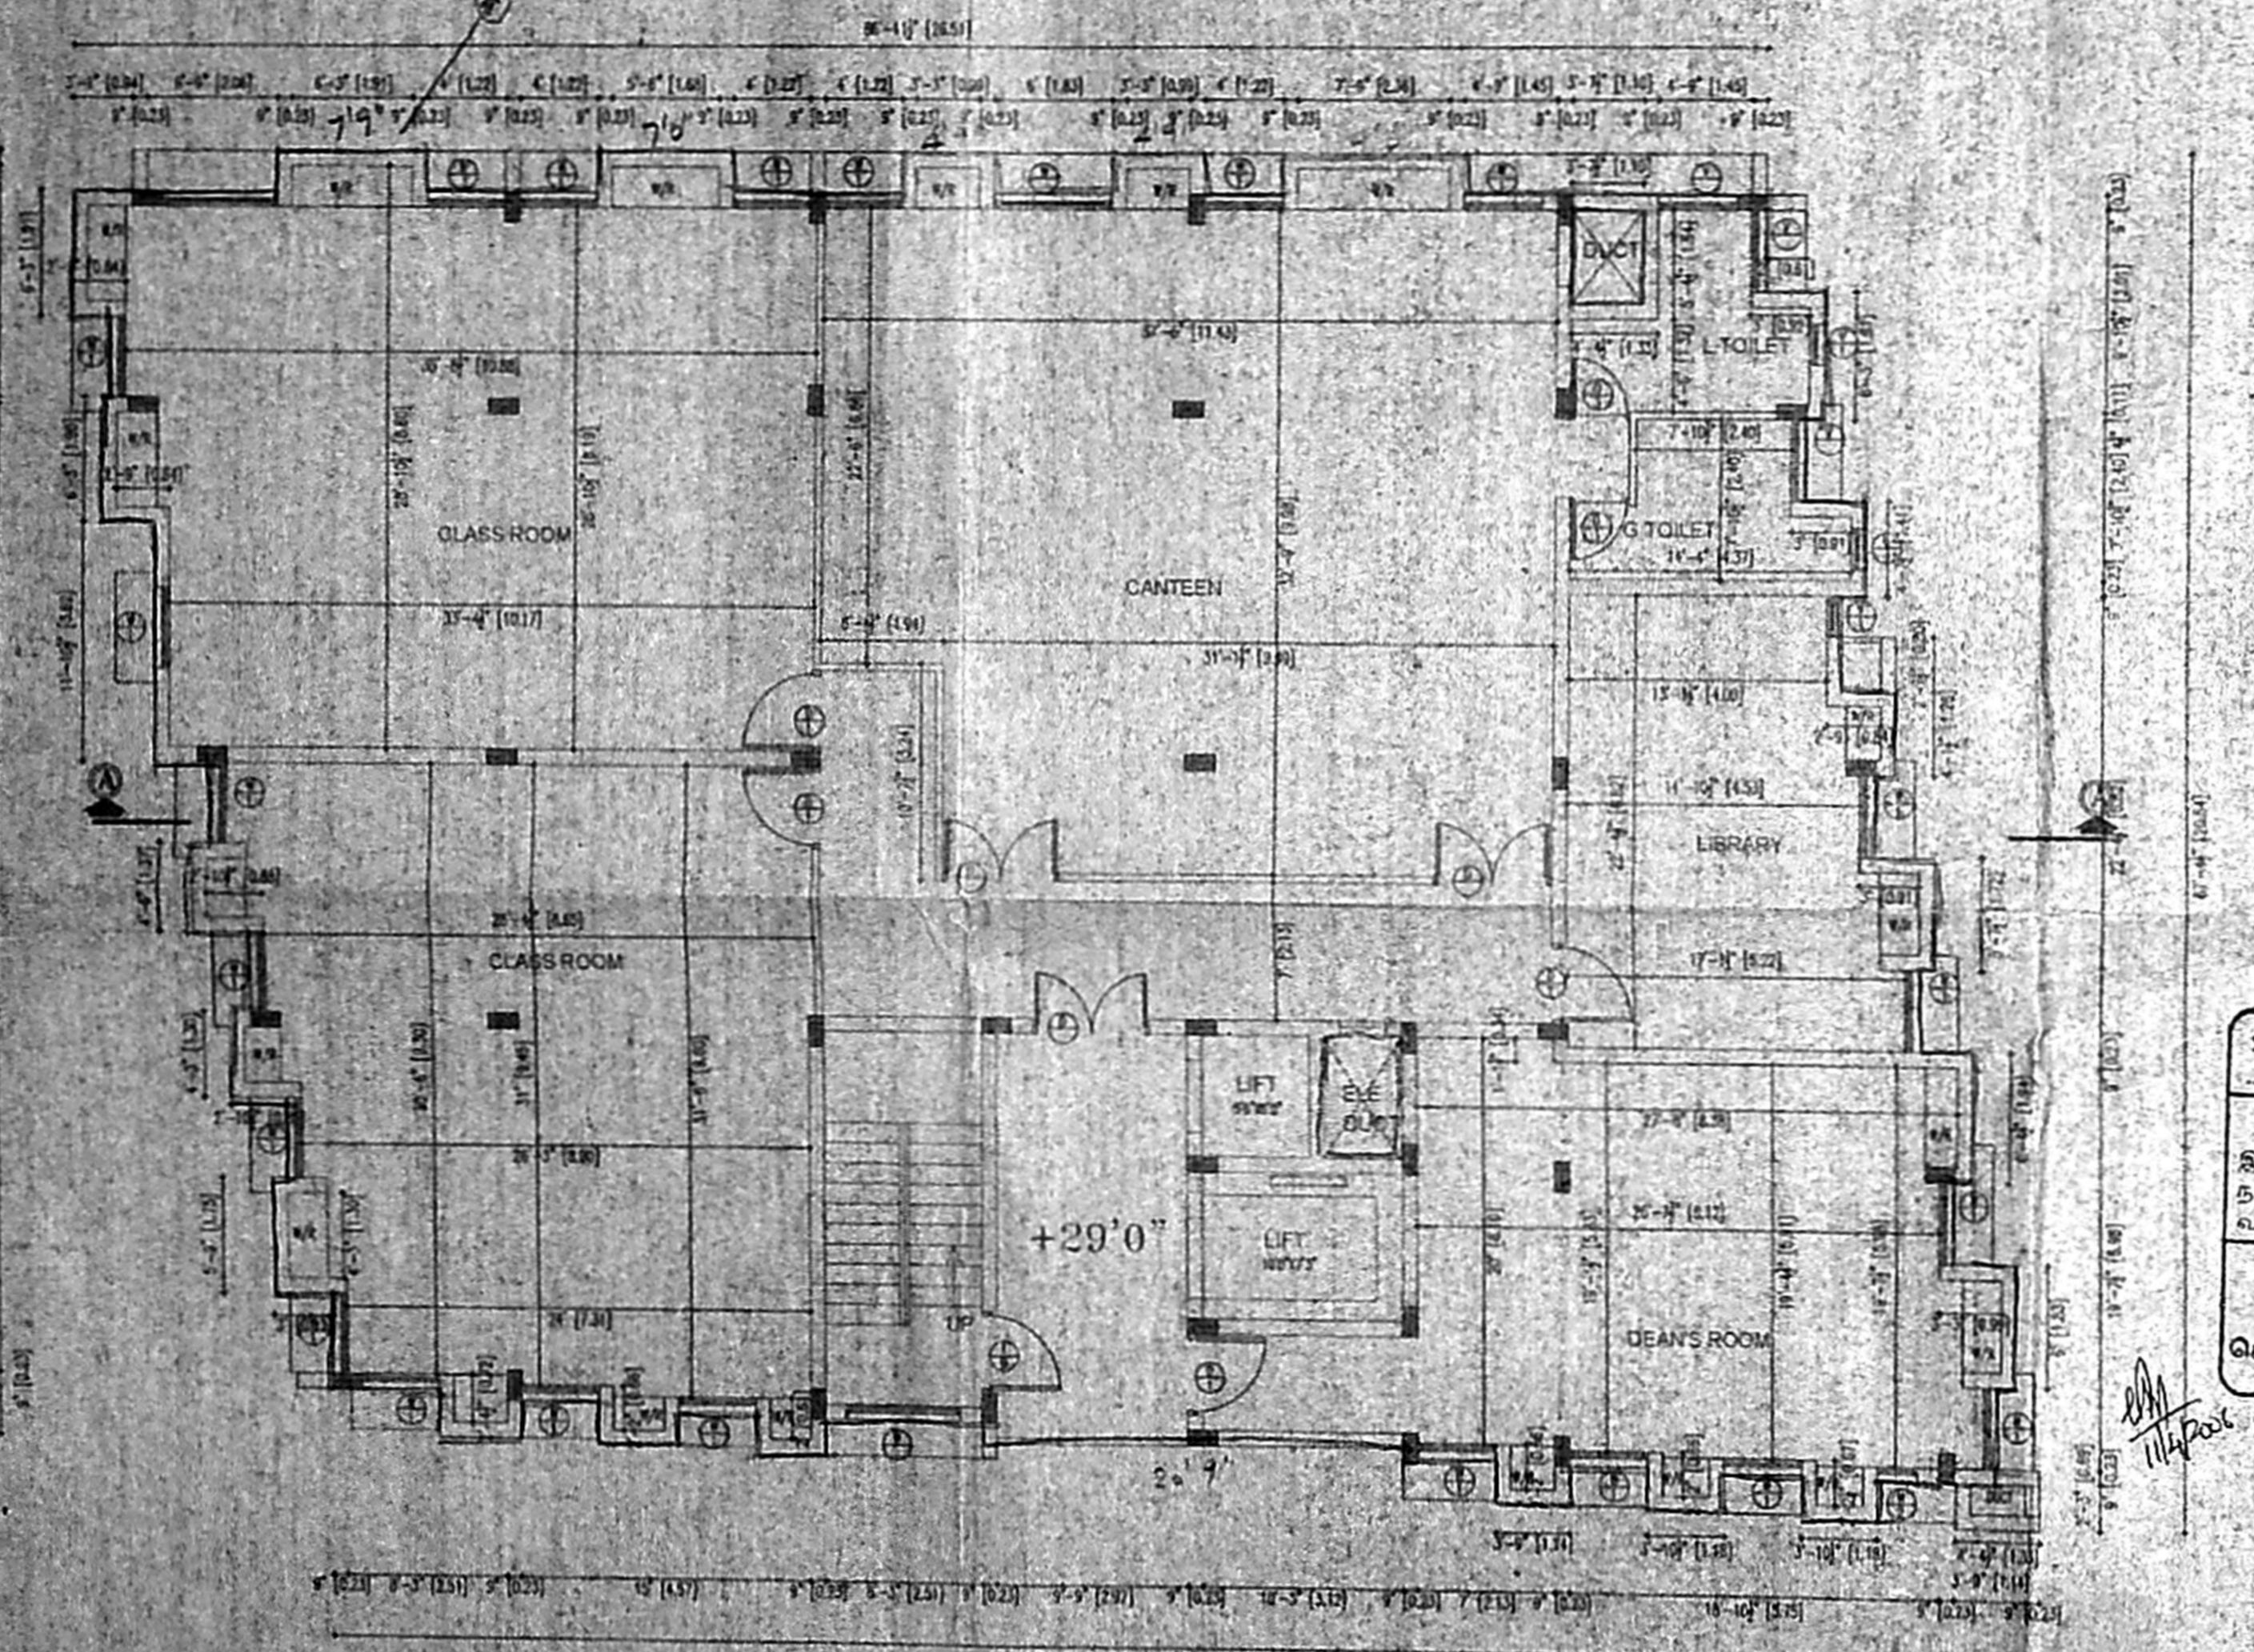

THIRD PLAN

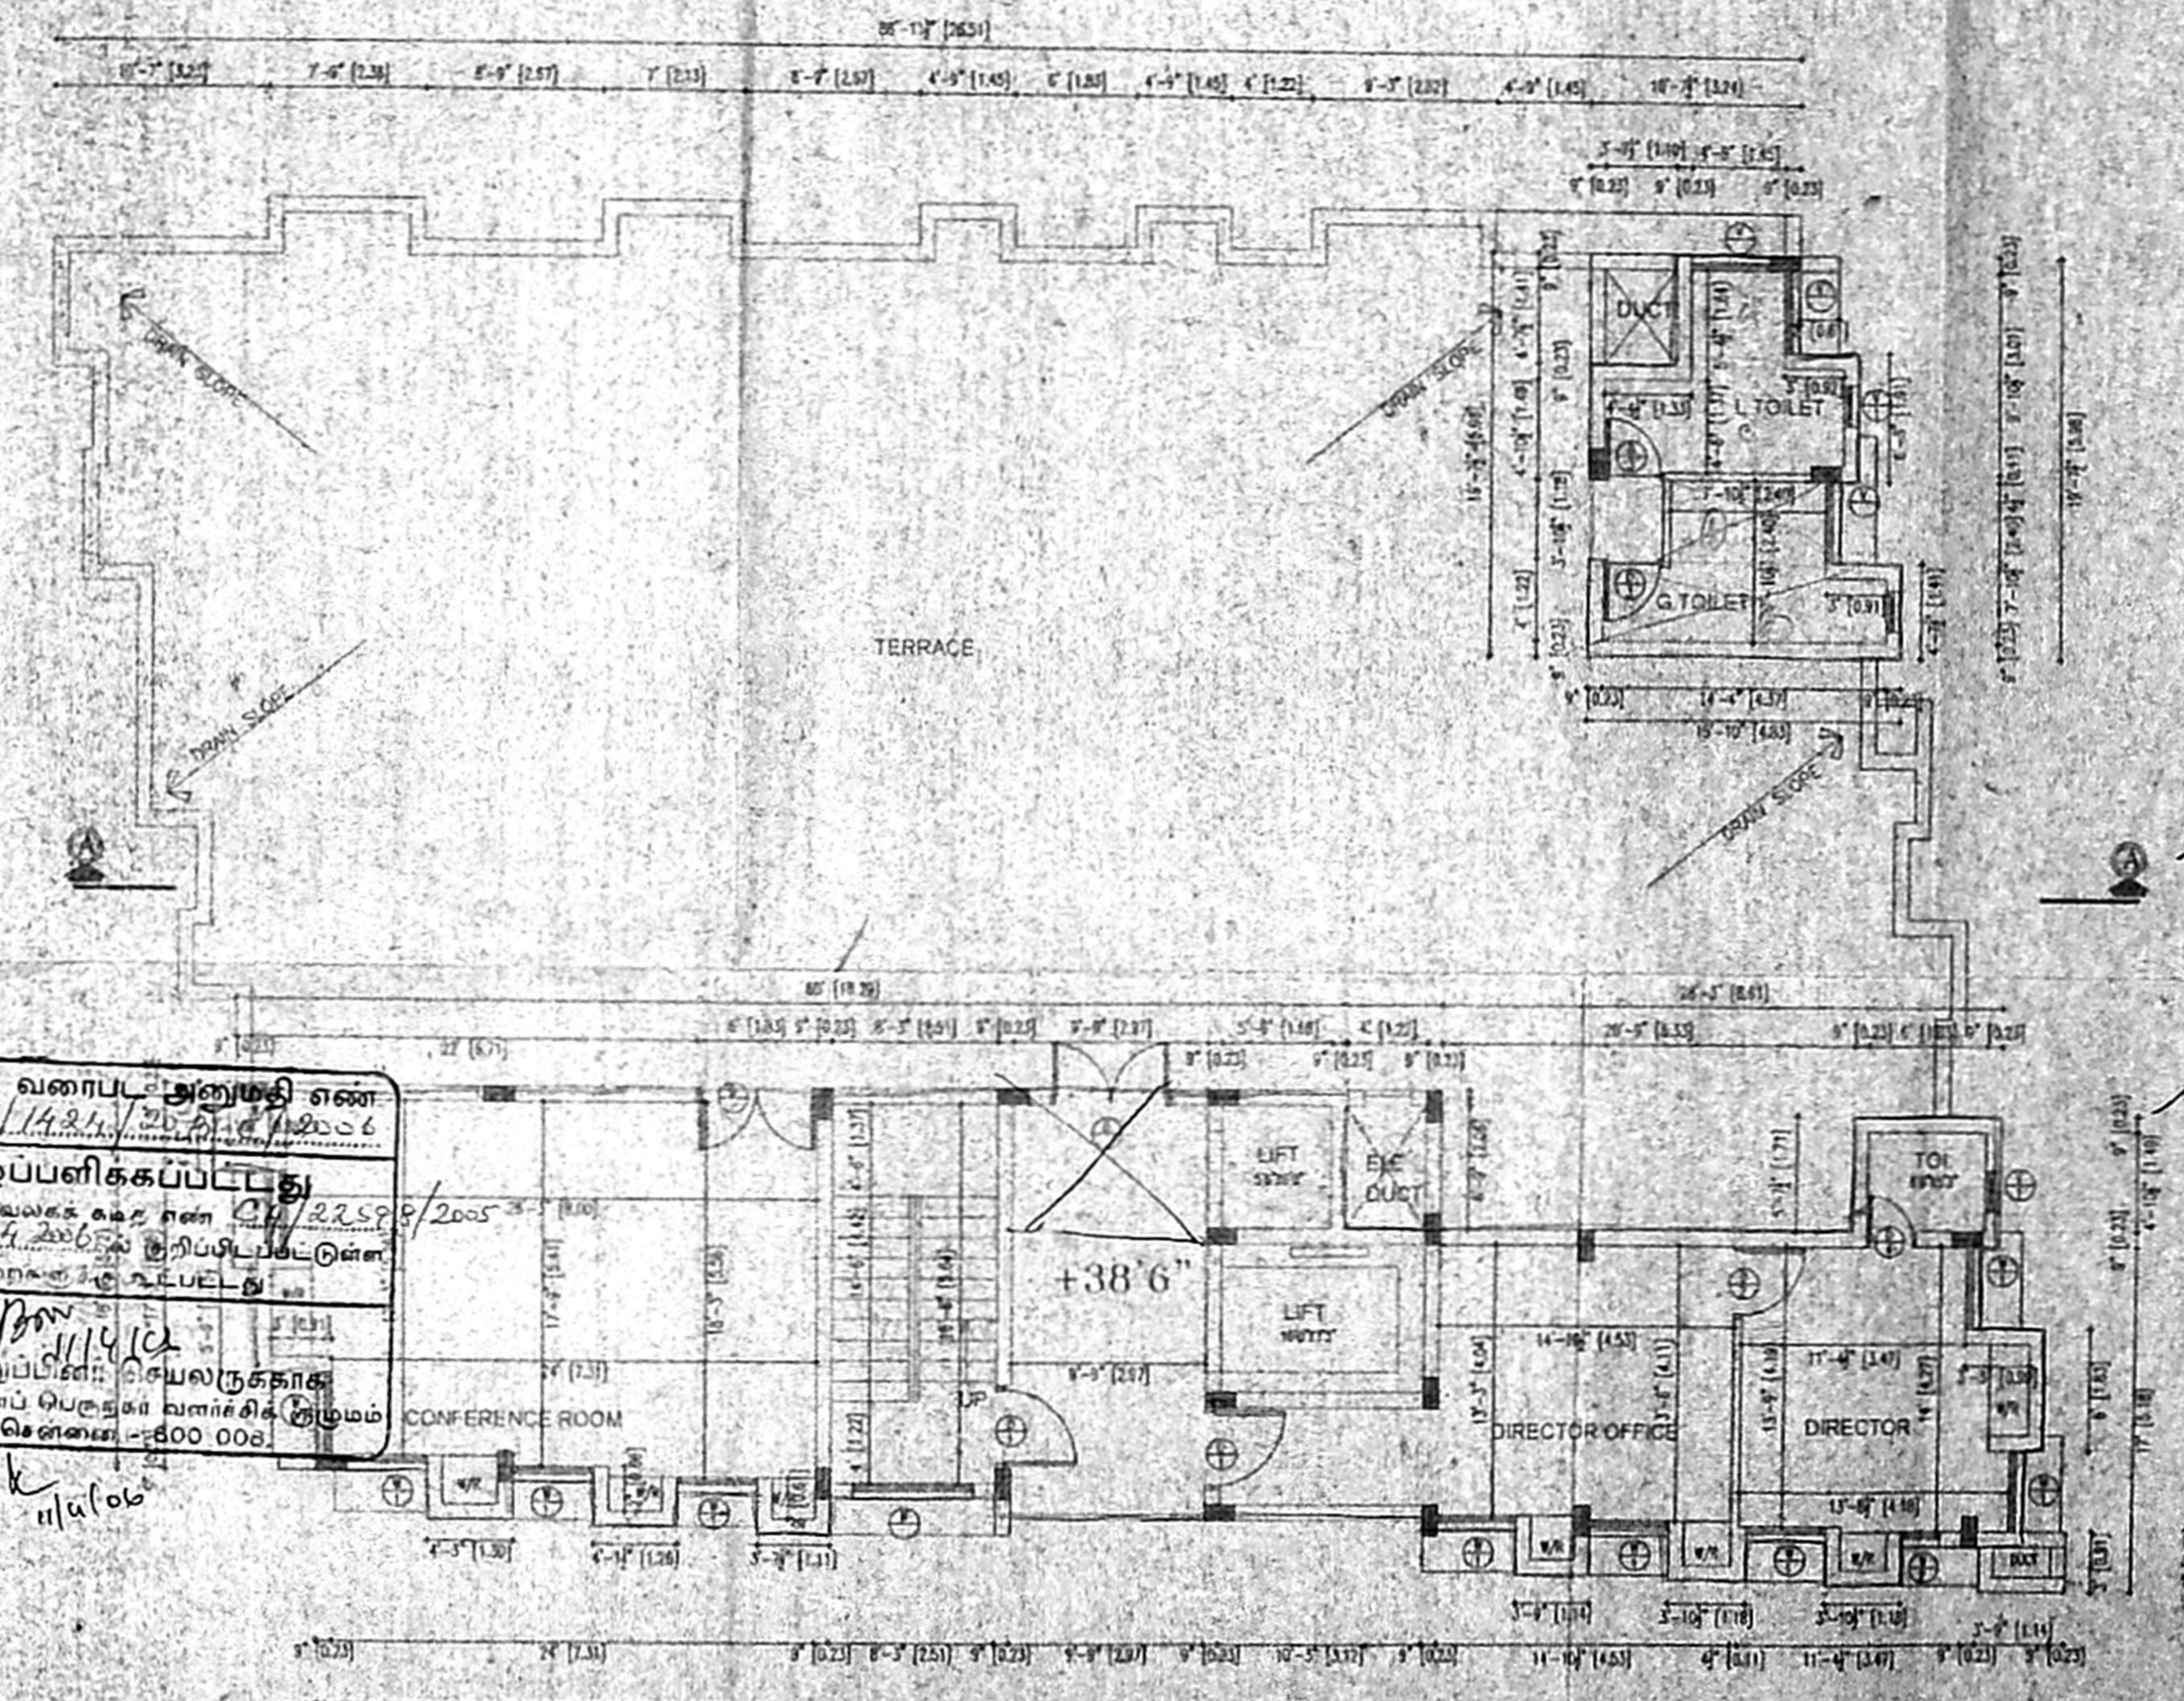


FOURTH PLAN

PLAN SHOWING THE PROPOSED
RESEARCH LAB & TRAINING CENTER
AT DOOR NO : 116/5, JAGANATHAN ROAD,
NUNGAMBAKKAM, CHENNAI-600 034
RS NO:116/5, 116/14, 2A/1200
BLOCK NO:20,NUNGAMBAKKAM,EGMORE,
NUNGAMBAKKAM TALUK,CHENNAI DIST. குடியிருப்பு
WARD NO: CORPN. ZONE- VII

69.5 X 51.5


கூவுவலக்கப் படி

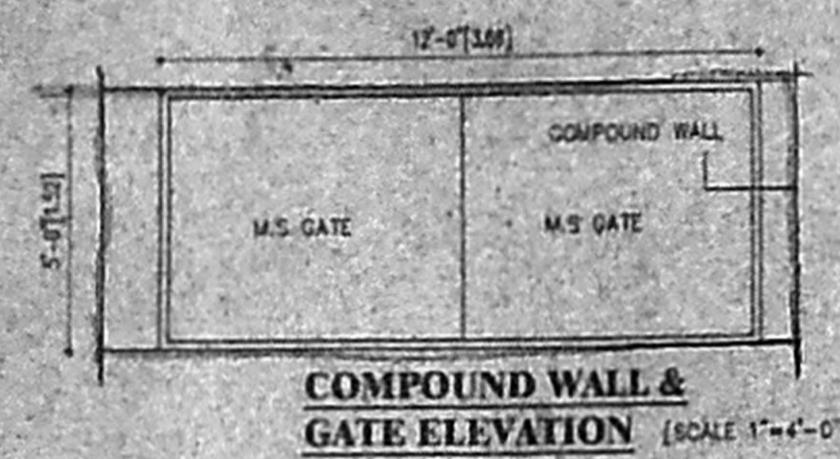


**COMPOUND WALL &
GATE ELEVATION** (SCALE 1"-4'-0"




**DWARF WALL
SECTION-EE**
(NOT TO SCALE)

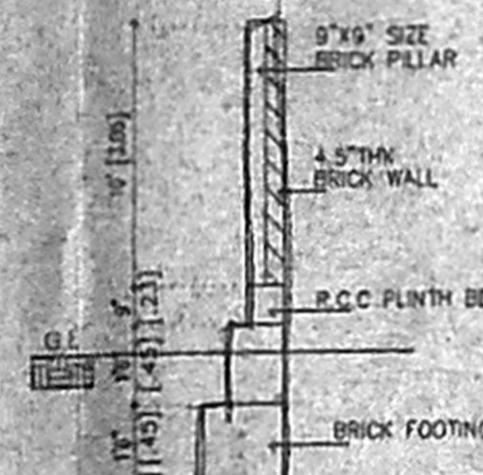


**SECTION OF
COMPOUND WALL**

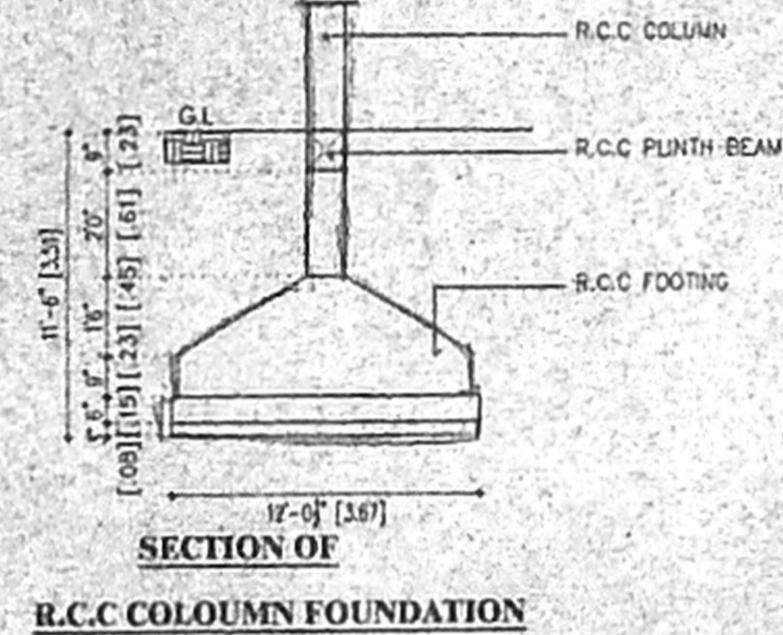

**SECTION OF
R.C.C COLOUMN FOUNDATION**

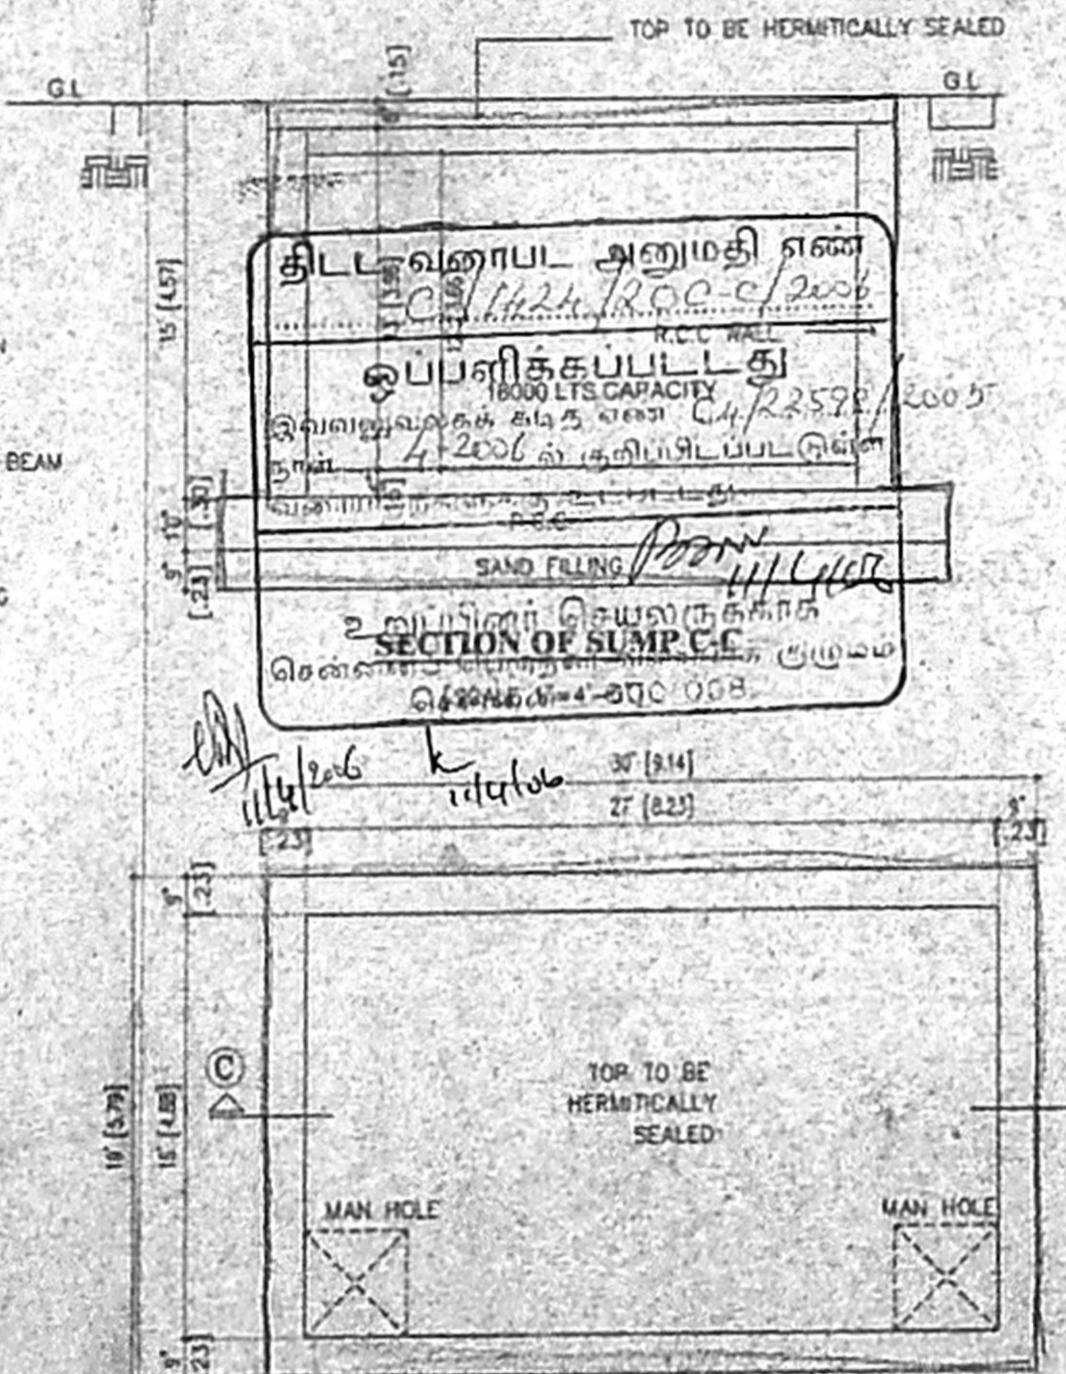

PLAN OF SUMP

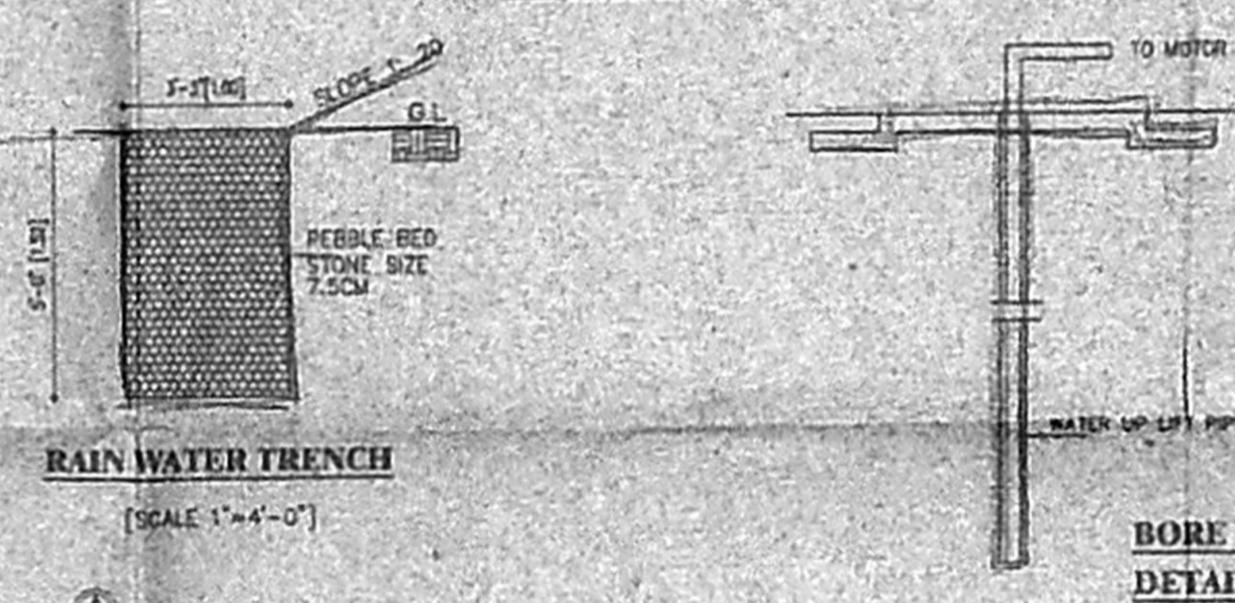

RAIN WATER TRENCH

[SCALE 1"-4'-0"

COLOUR CODE REFERENCE

- PROPOSED
- EXTG. ROAD
- BOUNDARY LINE
- WATER LINE
- SEWER LINE

SIGNATURE OF OWNER


CHANDAR SEETHABAMAN,
B.ARCH., M.H.A.I.I.A., A.I.I.D.
LICENSED SURVEYOR
CORPORATION OF MADRAS
REGISTERED ARCHITECT NO. 260
10/1/SUBBARAYA AVENUE, CHENNAI-18

SIGNATURE OF ARCHITECT


LICENCED SURVEYOR

CORPORATION DRAWING

DATE	19.12.05
DRAWN	CHENGALAIAH.N
SCALE	1"-8'-0"
DWG. NO	03

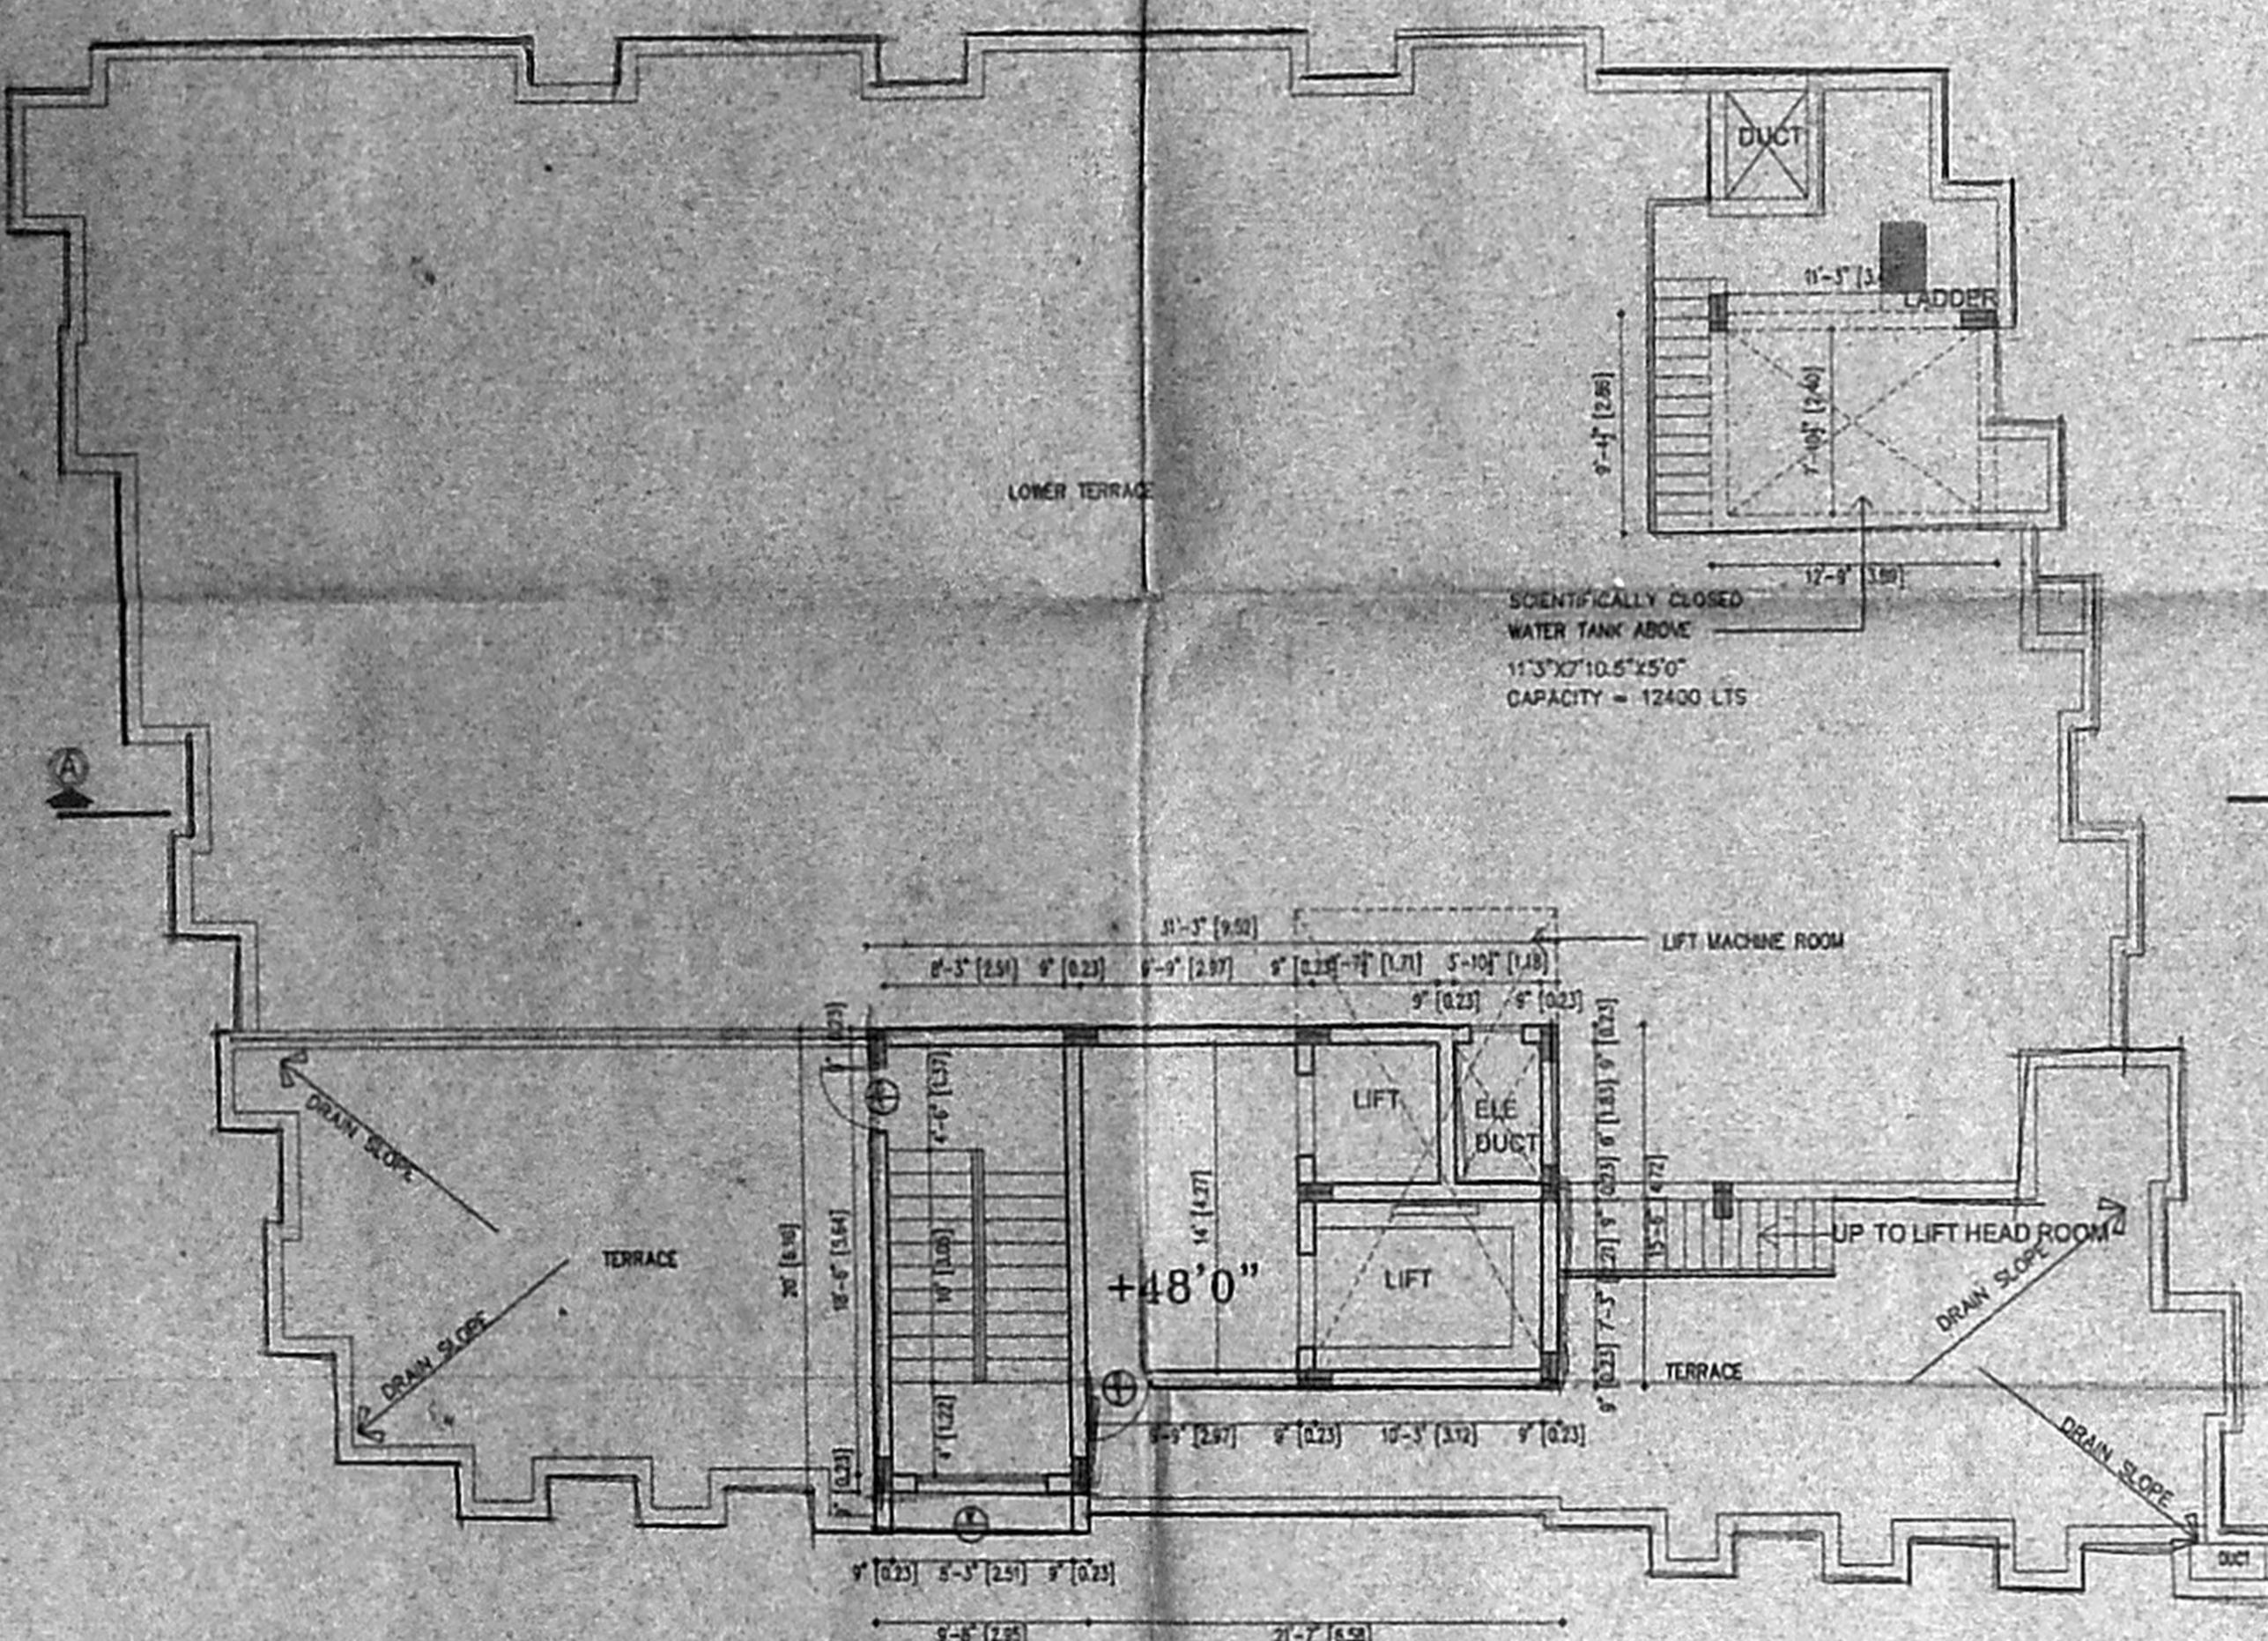

TERRACE PLAN

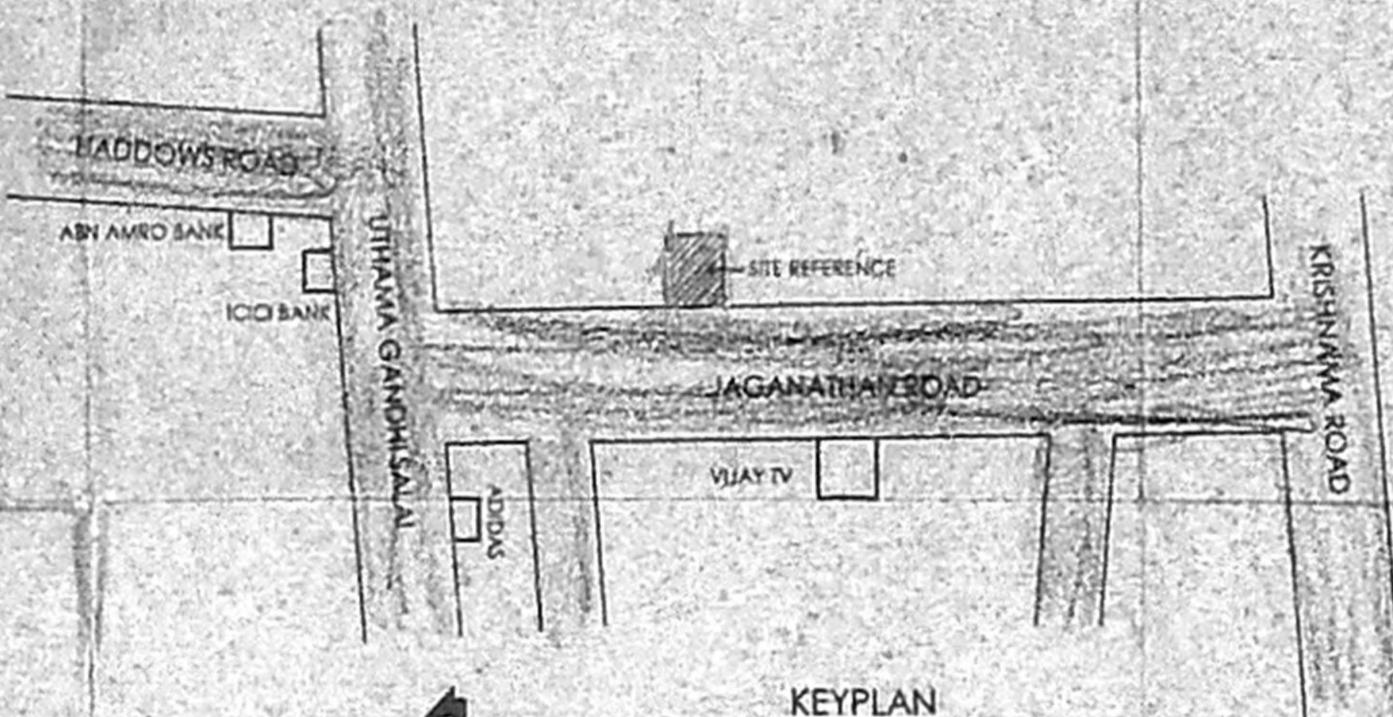

KEYPLAN
N.T.S.

N