# PLAN SHOWING THE PRO SUB DIVISION OF PLOT & PROPOSED CONSTRUCTION OF RESIDENTAL BUILDING AT R.S.NO.159/2, D.NO.4B, PERIYAMETTU PALAYAM LANE, SATHANGADU VILLAGE, THIRUVOTTIYUR MUNICIPAL LIMIT. SCALE = 1"=8'0" (1:100)

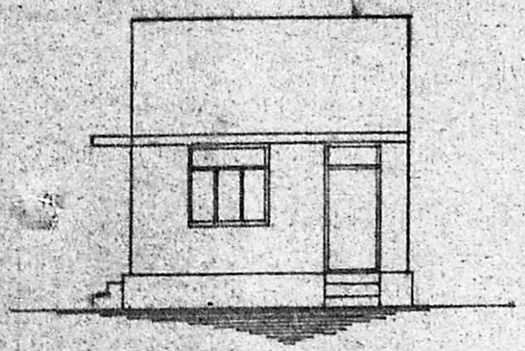

ELEVATION

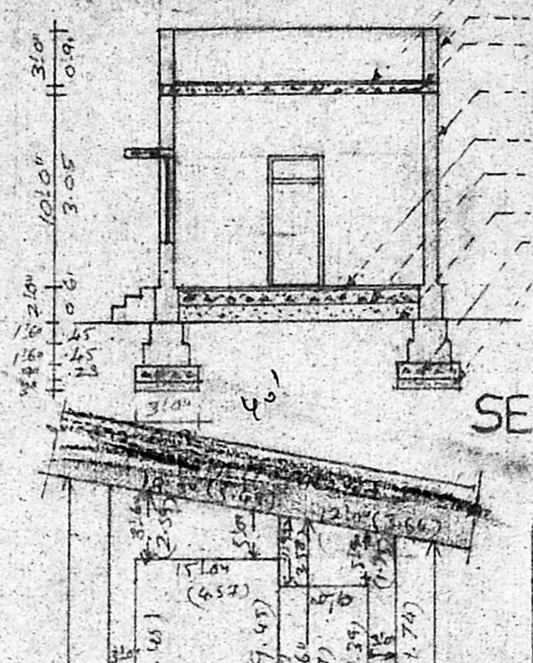


SECTION ON AA

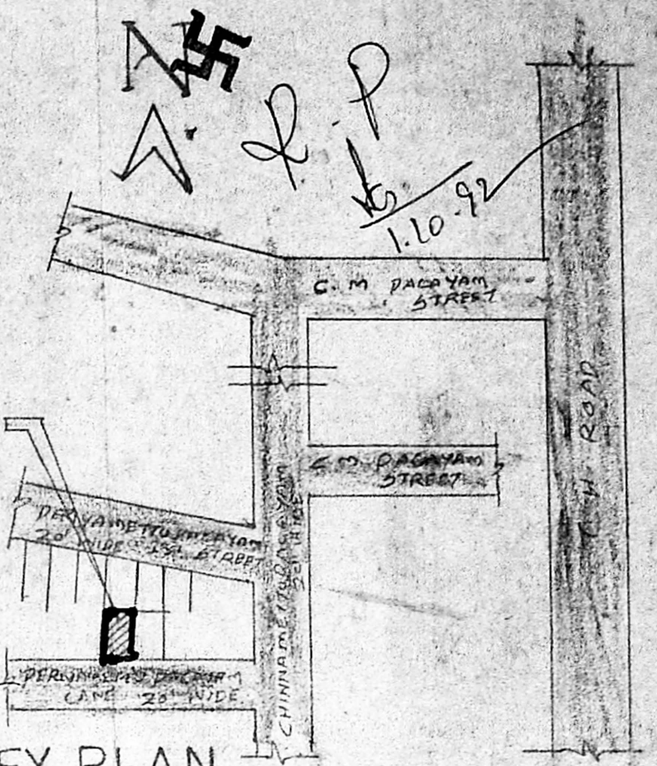


KEY PLAN (NOT TO SCALE)

Planning Permit No. A/1671/92

APPROVED

SUBJECT TO THE CONDITIONS IN THIS OFFICE LETTER.

No. A3/23232/92 dt. 11/92

FOR MEMBER SECRETARY
MADRAS METROPOLITAN DEVELOPMENT AUTHORITY
MADRAS - 600 008.

| | | |
|---|---|---|
| NAME OF PLOT | | |
| PRO. SUB DIVISION (A) | 77.36 | |
| RESIDURY PLOT (B) | 77.36 | |
| RESIDURY PLOT (C) | 46.28 | 1.14 |
| RESIDURY PLOT (D) | ~~46.28~~ 46.10 | ~~1.14~~ 1.14 |
| TOTAL | ~~247.28~~ 247.10 | 6.10 CENTS |
| SAY | | 6.00 CENTS |

## JOINERY DETAILS

| | (FTS) | (MTS) |
|---|---|---|
| D - DOOR | 3'3" x 7'0" | 1.00 x 2.13 |
| $D_1$ - DOOR | 3'0" x 7'0" | 0.91 x 2.13 |
| $D_2$ - DOOR | 2'6" x 7'0" | 0.76 x 2.13 |
| W - WINDOW | 4'6" x 4'6" | 1.37 x 1.37 |
| V - VENTILATOR | 3'0" x 2'0" | 0.91 x 0.61 |

| | | |
|---|---|---|
| AREA OF THE SITE | 832.5 SQ.FT | 77.36 SQ.MT |
| PRO. CONSTRUCTION AREA | 536.25 SQ.FT | 49.83 SQ.MT |
| PLOT COVERAGE | 64% | |
| F.S.I | 0.64 | |
| AREA OF THE OPEN SITE | 296.25 | 27.53 SQ.MT |
| PROPOSALS | PLOT BOUNDARY | |
| ROADS | TO BE REMOVED | |

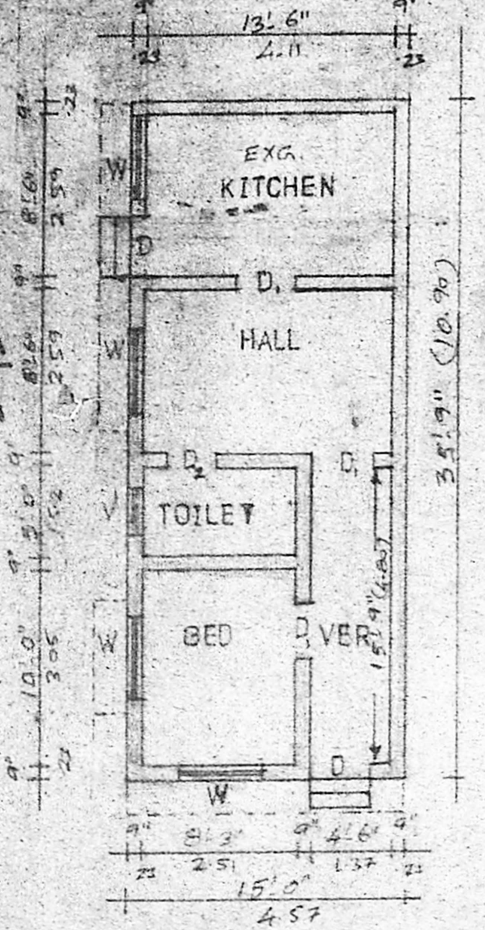


PLAN

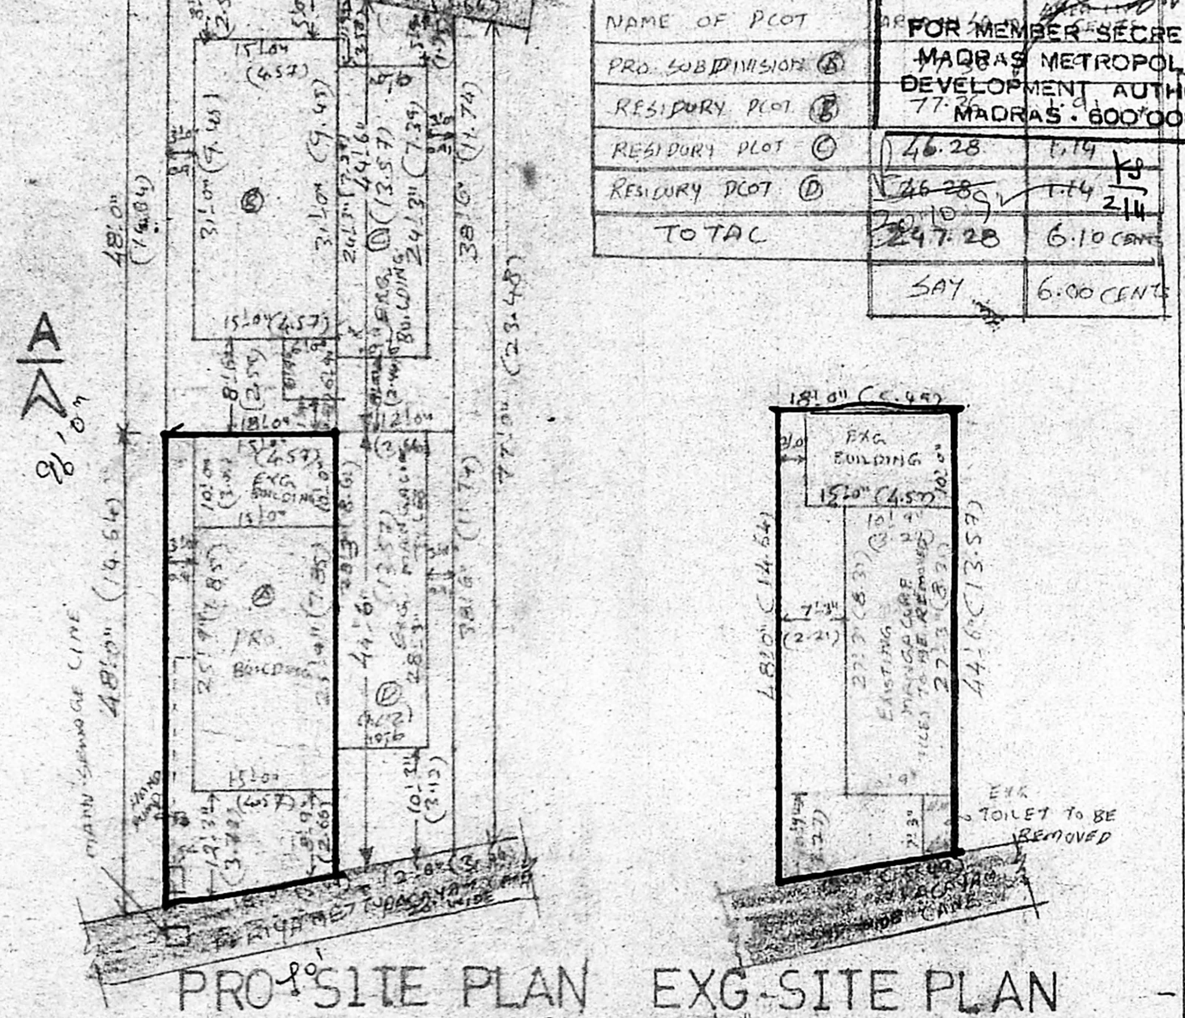


PRO. SITE PLAN EXG. SITE PLAN

SCALE = 1"=16'0" (1:200)

DRAWN BY : S. MURALI D.C.,

OWNER

S. MURALI, D.C.,
Licensed Surveyor,
Thiruvottiyur Municipality,
6-D. Amsagarden Ist St.,
Thiruvottiyur, Madras-19.

L.S.