PLAN SHOWING THE PROPOSED CONSTRUCTION OF A SALES BUILDING WITH INSTALLATION OF 28 HP

NEW "A" SITE AT NESAPAKKAM ROAD S.No 69PT,70,71,72 PT. 193 PT, 194 PT, OF KOYAMBEDU VILLAGE, CHENNAI DIVISION No 65, CORPORATION OF CHENNAI. SCALE 1:100

Planning Permit No 027101/44/SS

APPROVED
SUBJECT TO THE CONDITIONS IN THIS OFFICE LETTER.
No C2/25818/SS Date -11-SS
FOR MEMBER SECRETARY
CHENNAI METROPOLITAN DEVELOPMENT AUTHORITY
CHENNAI-600 008.

CMDA 'C'/PP No. 1
C. No C2/25818/SS
Asst.
Scrutiny
PART I
PART II

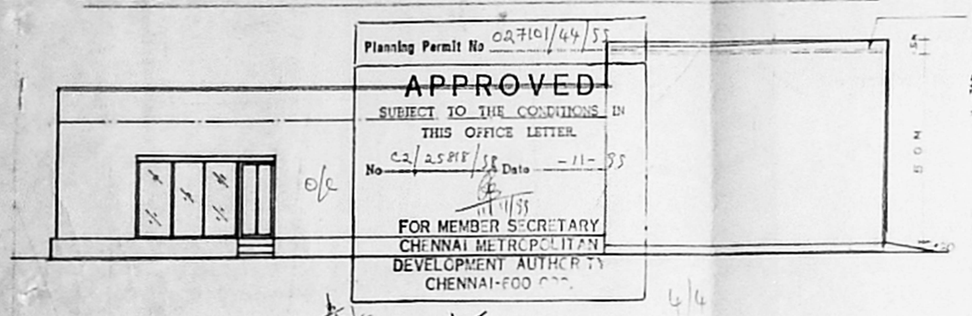

Front Elevation

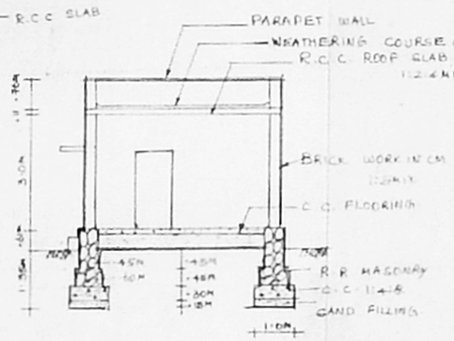

A Section on GH

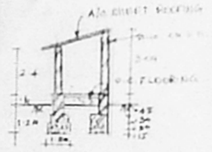

SECTION ON AB

PLAN 1B

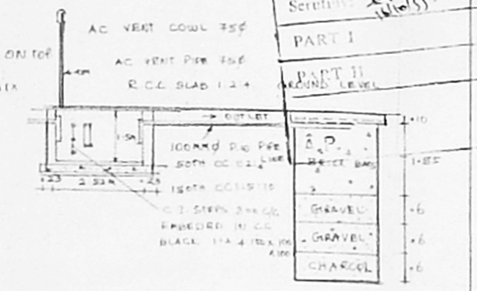

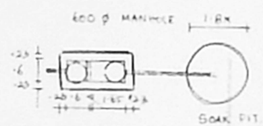

PLAN AND SECTION OF SEPTIC TANK.

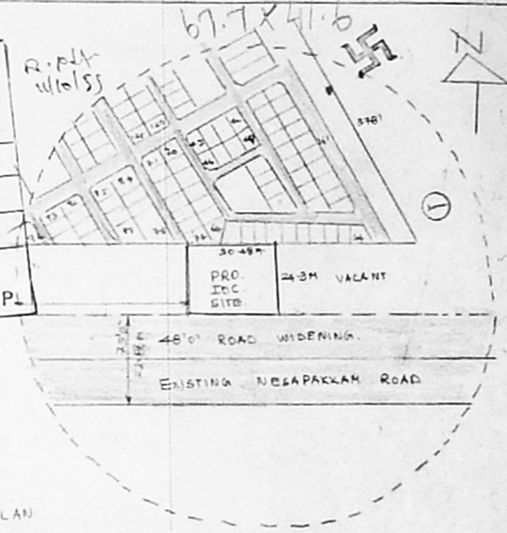

KEY PLAN
NOT TO SCALE

COLOURING DETAILS

SITE BOUNDRY SHOWN IN BLACK.
PRO. SHOWN IN RED.
ROADS ARE SHOWN IN GREEN.
DISMANTLED SHOWN IN YELLOW.

REFERENCE.

D	- DOOR	3.0M X 2.1M
D_1	- DOOR	.76M X 1.8M
W	- WINDOW	.74M X 1.2M
V	- VENTILATOR	.61M X .90M
GW	- GLASS WINDOW	2.7M X 2.1M

AREA DETAILS

	Sq.M.	Sq.Ft.
TOTAL AREA OF THE SITE	740.66	P.S.I. 0.144
PLINTH AREA OF PRO. CONSTN.	106.54 Sq.M.	SR.FT SQ.M
DISMANTLING OF EXG. TOILET & SWITCH ROOM	1315	29.2

K.G. BABU
ASST. MANAGER 3) &
DISTRICT CO-ORDINATOR
INDIAN OIL CORPORATION LTD.
CHENNAI DIVISION
730, ANNA SALAI, CHENNAI-600 002

S. KANDAVEL, D.C.E.,
Consulting Civil Engineer &
Licensed Surveyor No 271 Class I,
CHENNAI CORPORATION
SRI RAGHAVENDRA CONSTRUCTIONS
312/3, M.T.H. ROAD,
THIRUNINRAVUR - 602024.
☎ 6350298

INDIANOIL CORPORATION LIMITED
MARKETING DIVISION
CHENNAI DIVISIONAL OFFICE

SITE PLAN

SCALE 1:200

NOTE :- PRO. SHOWN IN RED.

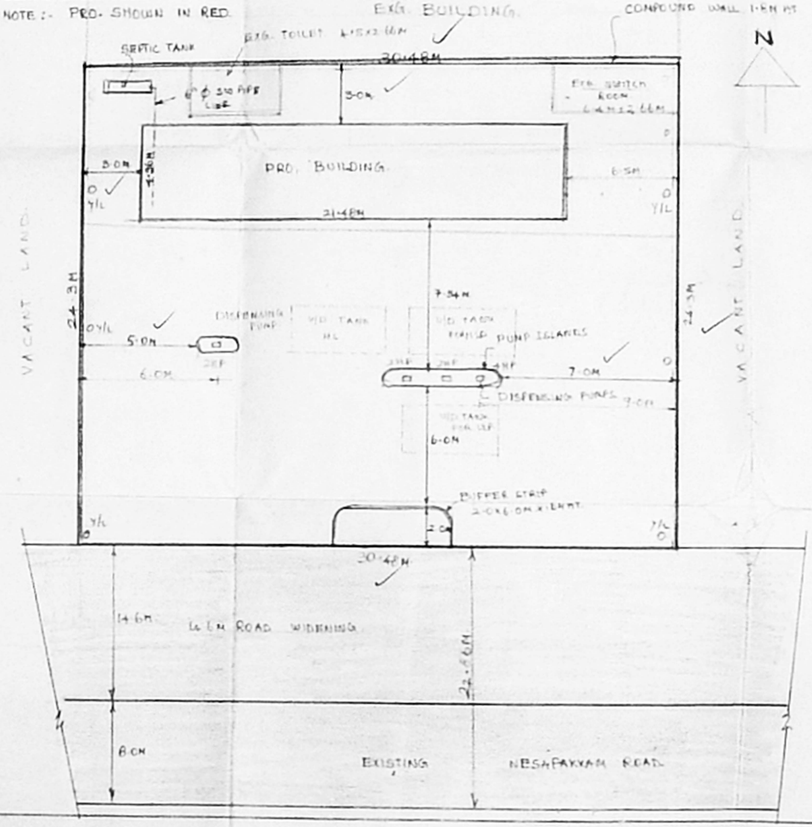

I. DISPENSING PUMPS 1 NO DUO PUMP 4 HP
2 HP PER PUMP 3 NOS NO PUMP 6 HP
5 HP
CONPRESSOR 3 HP
CAR WASHER 1 HP
WATER PUMP

6 NOS YARD LIGHTS	1500 WATTS	9 H.P.
FANS, TUBE LIGHTS	3000 WATTS	
WALK WAY LIGHTS	1000 WATTS	
SPARE	1000 WATTS	
	6500 WATTS	TOTAL 28 HP

II. TOTAL NO OF EMPLOYEES 8 NOS

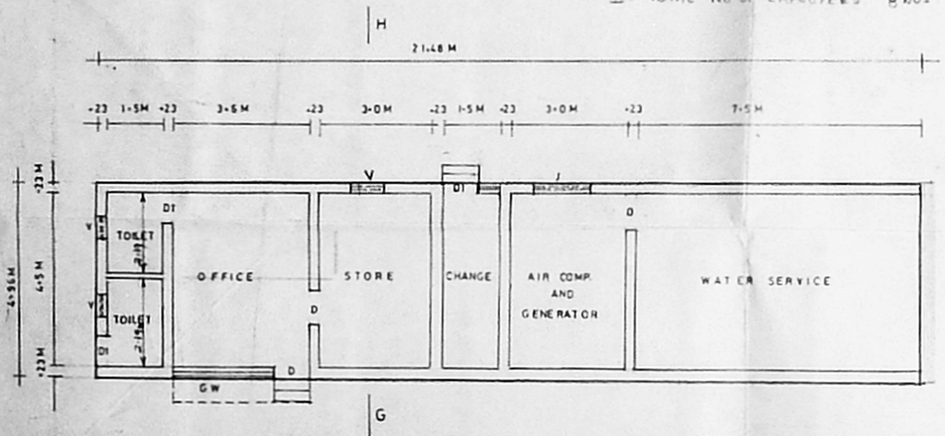

Plan